

SKYE CANYON PARCEL 2.15 PHASE 1

Recorded in Book 155 Page 057 of Plats

MASTER SITE ADDRESS: 10290 EAGLE CANYON AVE

Zip Code: 89166

Fire Department District Map Numbers:

01314-58 01314-67 01314-68 01314-77 01314-78

<u>Block</u>	<u>Lot</u>	<u>Address</u>
	1	10285 SIERRA SKYE AVE
	2	10279
	3	10273
	4	10267
	5	10261
	6	10255
	7	8224 SKYE TERRITORY ST
	8	8230
	9	8236
	10	8242
	11	8248
	12	8254
	13	8260
	14	8266
	15	8272
	16	8278
	17	8284
	18	8290
	19	8296
	20	8302
	21	8306
	22	8312
	23	10256 MIDNIGHT METEOR AVE
	24	10262
	25	10268
	26	10274
	27	10280
	54	10280 SIERRA SKYE AVE
	55	10274

SNC-73232

SKYE CANYON PARCEL 2.15 PHASE 1

Recorded in Book 155 Page 057 of Plats

MASTER SITE ADDRESS: 10290 EAGLE CANYON AVE


Zip Code: 89166

Fire Department District Map Numbers:

01314-58 01314-67 01314-68 01314-77 01314-78

<u>Block</u>	<u>Lot</u>	<u>Address</u>
	56	10268 SIERRA SKYE AVE
	57	10262
	58	10256
	59	10255 TIMBERLINE VALLEY AVE
	60	10261
	61	10267
	62	10273
	63	10279
	74	10280
	75	10274
	76	10268
	77	10262
	78	10256
	79	10255 MIDNIGHT METEOR AVE
	80	10261
	81	10267
	82	10273
	83	10279

Mark Rex, Planner II

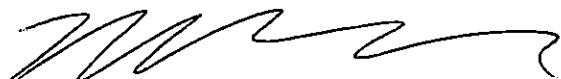

SKYE CANYON PARCEL 2.15 PHASE 1

Recorded in Book 155 Page 057 of Plats

MASTER SITE ADDRESS: 10290 EAGLE CANYON AVE

Zip Code: 89166

Fire Department District Map Number:

01314-67

<u>Block</u>	<u>Lot</u>	<u>Address</u>
	1	10285 SIERRA SKYE AVE
	2	10279
	3	10273
	4	10267
	5	10261
	6	10255
	7	8224 SKYE FOOTHILLS ST
	8	8230
	9	8236
	10	8242
	11	8248
	12	8254
	13	8260
	14	8266
	15	8272
	16	8278
	17	8284
	18	8290
	19	8296
	20	8302
	21	8306
	22	8312
	23	10256 MIDNIGHT METEOR AVE
	24	10262
	25	10268
	26	10274
	27	10280
	54	10280 SIERRA SKYE AVE
	55	10274

VOID
SEE REVISED PLAN DATE
STAMPED 7/23/10

SKYE CANYON PARCEL 2.15 PHASE 1

Recorded in Book 155 Page 057 of Plats

MASTER SITE ADDRESS: 10290 EAGLE CANYON AVE

Zip Code: 89166


Fire Department District Map Number:

01314-67

<u>Block</u>	<u>Lot</u>	<u>Address</u>
	56	10268 SIERRA SKYE AVE
	57	10262
	58	10256
	59	10255 TIMBERLINE VALLEY AVE
	60	10261
	61	10267
	62	10273
	63	10279
	74	10280
	75	10274
	76	10268
	77	10262
	78	10256
	79	10255 MIDNIGHT METEOR AVE
	80	10261
	81	10267
	82	10273
	83	10279



Mark Rex, Planner II

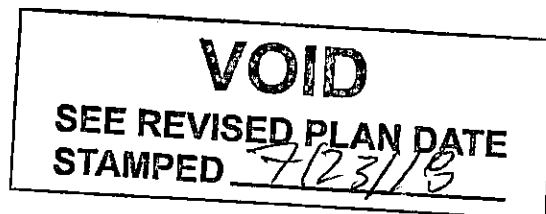



**LAS VEGAS
CITY COUNCIL**

CAROLYN G. GOODMAN
Mayor

LOIS TARKANIAN
Mayor Pro Tem

STAVROS S. ANTHONY

BOB COFFIN

STEVEN G. SEROKA

MICHELE FIORE

CEDRIC CREAR

SCOTT D. ADAMS
City Manager

DEPARTMENT OF PLANNING
ROBERT SUMMERFIELD
DIRECTOR

**DEVELOPMENT
SERVICES CENTER**
DEPARTMENT OF PLANNING

333 N. RANCHO DRIVE
3RD FLOOR
LAS VEGAS, NV 89106
702.229.6301 | VOICE
702.474.7463 | FAX
711 | TTY



cityoflasvegas
lasvegasnevada.gov

July 19, 2018

Mr. Dan Hale
Pardee Homes of Nevada
4675 West Teco Avenue, Suite #215
Las Vegas, Nevada 89118

**RE: SNC-73232 [PRJ-73132] - STREET NAME CHANGE
CITY COUNCIL MEETING OF JULY 18, 2018**

Dear Mr. Hale:

The City Council at a regular meeting held on July 18, 2018 voted to **APPROVE** a request for a Street Name Change FROM: SKYE FOOTHILLS STREET TO: SKYE TERRITORY STREET, generally located north of Eagle Canyon Avenue, west of Skye Village Road, Ward 6 (Fiore) [PRJ-73132].

This approval is subject to the following conditions:

Public Works

1. The applicant shall be responsible for all costs related to this Street Name Change, including signage and installation.

The Notice of Final Action was filed with the Las Vegas City Clerk on July 19, 2018.

Sincerely,

Robert Summerfield, AICP
Director
Department of Planning

RTS:SG:clb:nl

cc: Ms. Chelsea Jensen
Slater Hanifan Group
5740 South Arville Street, Suite #216
Las Vegas, Nevada 89118