

Keep this in folder

# ELEVENTH STREET LOFT HOMES

Recorded in Book 126 Page 098 of Plats

MASTER SITE ADDRESS: 1150 CARSON AVE

Fire Department District Map Numbers:

02426-61

<u>Block</u>	<u>Lot</u>	<u>Address</u>
	1	117 S 11TH ST
	2	121
	3	125
	4	129
	5	133
	6	137
	7	1126 CARSON AVE
	8	1122
	9	1116
	10	1114
	11	1110
	12	1106
	13	1130
	14	1134
	15	1138
	16	1142
	17	1146
	18	1152
	19	1174
	20	1170
	21	1166
	22	1162
	23	1158
	24	1154
	25	1178
	26	1182
	27	1186
	28	1190
	29	1194
	30	1198

this is the same →


these (lots 8-11) addresses have been changed to be compatible with already used addresses across the street.

ORIGINAL LIST

Replaced by REVISED LIST NOV. 01, 2006

*Robert T. Summerfield*  
Robert T. Summerfield, Planner I

*Field Copy*

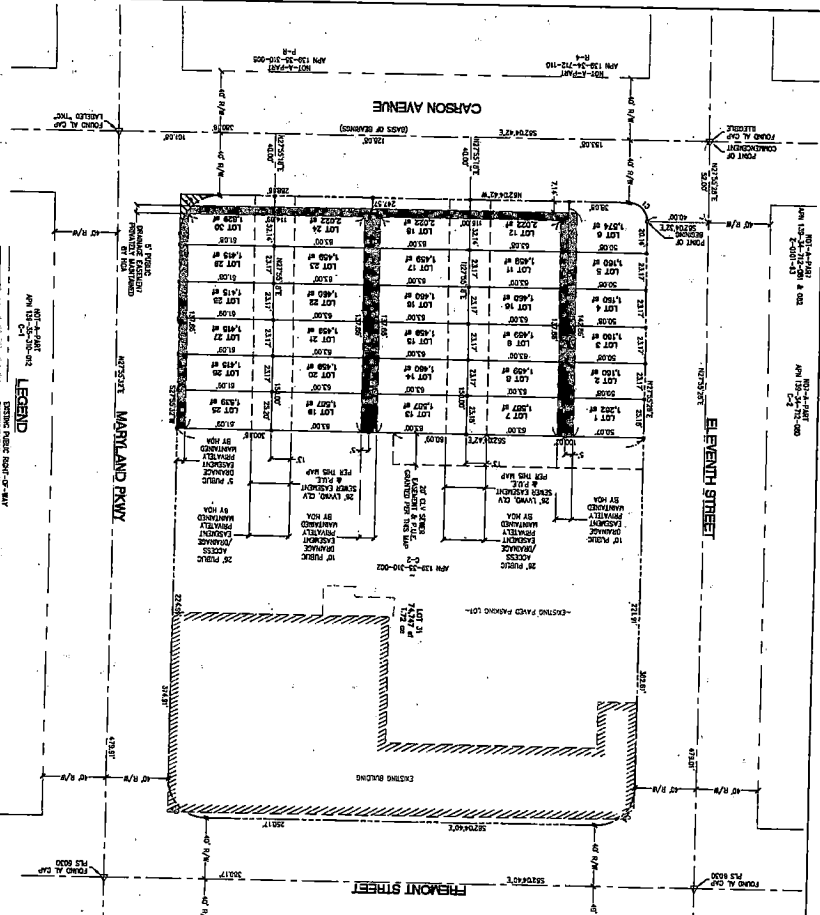

**LEGEND**





**VISIBILITY MAP**

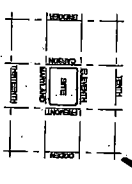



