

VILLAGE 20 - SUMMERLIN PARCEL T&U - UNIT 2

Recorded in Book 106 Page 55 of Plats

200 Scale Map Location: K-26-5

Fire Dept. District Map # 2313:73


MASTER SITE ADDRESS: 11526 CAMEO AVE

BLOCK 1	LOT	47	85	ALERION ST	N/S	PUBLIC STREET
		48	81			
		49	77			
		50	73			
BLOCK 1	LOT	73	80	COPPER FOUNTAIN ST	N/S	PUBLIC STREET
		74	84			
		75	88			
		76	92			
		77	96			
BLOCK 1	LOT	78	11505	CAMEO AVE	E/W	PUBLIC STREET
		79	11509			
		80	11513			
		81	11517			
		82	11521			
		83	11525			
BLOCK 5	LOT	125	77	ESCONDIDO CANYON ST	N/S	PUBLIC STREET
		126	81			
		127	85			
		128	89			
BLOCK 5	LOT	130	88	ALERION ST	N/S	PUBLIC STREET
		131	84			
		132	80			
BLOCK 6	LOT	137	92	ESCONDIDO CANYON ST	N/S	PUBLIC STREET
		138	88			
		139	84			
		140	80			
		141	76			
BLOCK 6	LOT	148	11500	LONE POINT CT	E/W	PUBLIC STREET
		149	11504			
		150	11508			
		151	11512			
		152	11509			
		153	11505			
Common Area	A	93		COPPER FOUNTAIN ST	N/S	PUBLIC STREET

No addresses on KENWOOD STREET, CARRIAGE HILLS DRIVE (N/S Public Streets) or VISTA RUN DRIVE (E/W Public Street).

ORIGINAL DATE: 9/16/2002

CITY OF LAS VEGAS
PLANNING & DEVELOPMENT DEPARTMENT

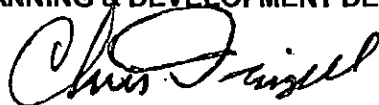

CHRIS DINGELL, PLANNER I

VILLAGE 20 - SUMMERLIN PARCEL T&U - UNIT 2

Recorded in Book 106 Page 55 of Plats

200 Scale Map Location: K-26-5

Fire Dept. District Map # 2313:73

MASTER SITE ADDRESS: 11526 CAMEO AVE

BLOCK 1	LOT	47	85	ALERION ST	N/S	PUBLIC STREET
		48	81			
		49	77			
		50	73			
BLOCK 1	LOT	73	80	COPPER FOUNTAIN ST	N/S	PUBLIC STREET
		74	84			
		75	88			
		76	92			
		77	96			
BLOCK 1	LOT	78	11505	CAMEO AVE	E/W	PUBLIC STREET
		79	11509			
		80	11513			
		81	11517			
		82	11521			
		83	11525			
BLOCK 5	LOT	125	77	ESCONDIDO CANYON ST	N/S	PUBLIC STREET
		126	81			
		127	85			
		128	89			
BLOCK 5	LOT	130	88	ALERION ST	N/S	PUBLIC STREET
		131	84			
		132	80			
BLOCK 6	LOT	137	92	ESCONDIDO CANYON ST	N/S	PUBLIC STREET
		138	88			
		139	84			
		140	80			
		141	76			
BLOCK 6	LOT	148	11500	LONE POINT CT	E/W	PUBLIC STREET
		149	11504			
		150	11508			
		151	11512			
		152	11509			
		153	11505			
Common Area	A	93		COPPER FOUNTAIN ST	N/S	PUBLIC STREET

No addresses on KENWOOD STREET, CARRIAGE HILLS DRIVE (N/S Public Streets) or VISTA RUN DRIVE (E/W Public Street).

ORIGINAL DATE: 9/16/2002

CITY OF LAS VEGAS
PLANNING & DEVELOPMENT DEPARTMENT



CHRIS DINGELL, PLANNER I

William Lyp...
Santolina

USA# 439484

Clears: 10/23/20 12:45

LOT B3 BCL5 I


EXP: 1/14

11525 - CAMPO AV

TEMP PWR POLE

PC L-903-02 APP 568528

Call before you Dig
1-800-272-6800
Call before you Overhead
1-202-592-6111

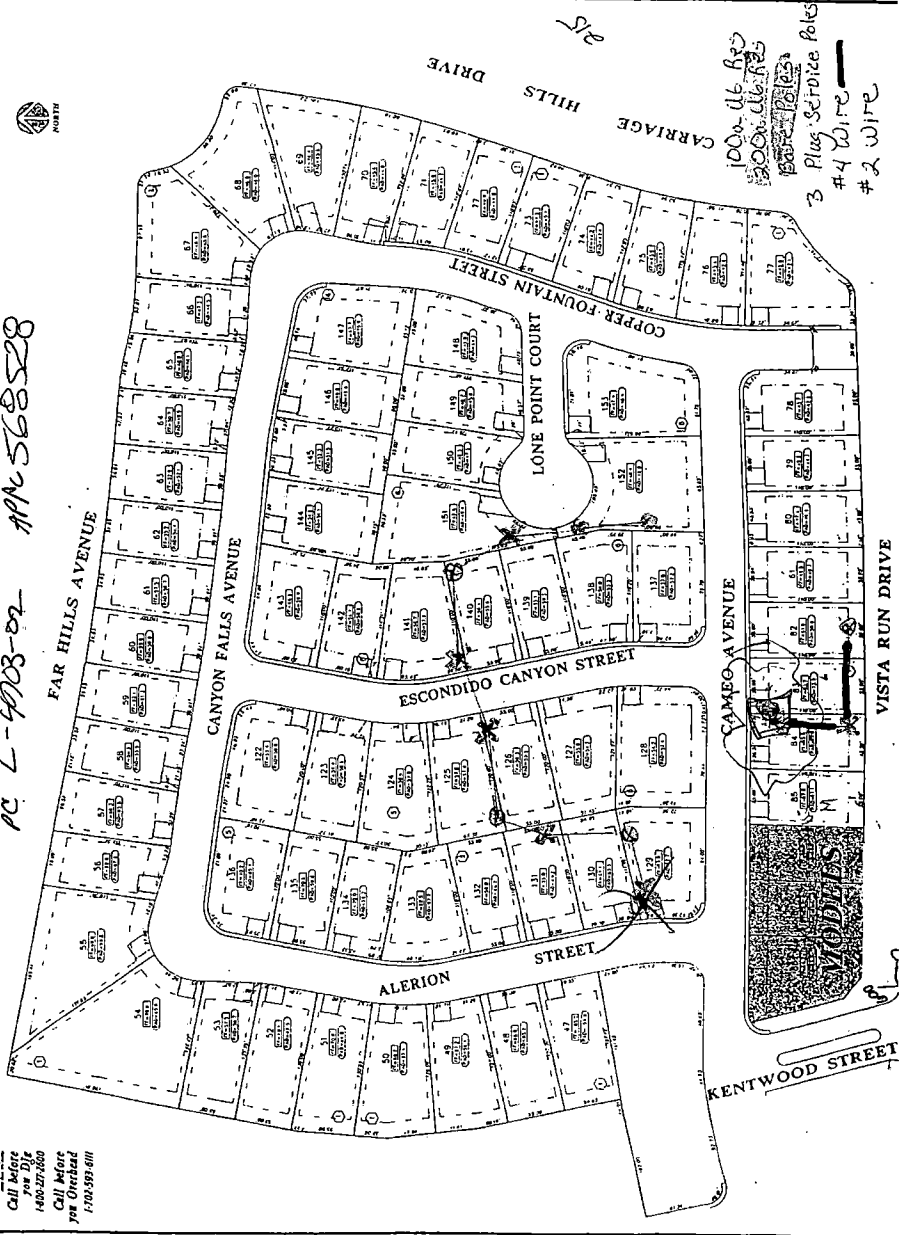

KENTWOOD STREET

VISTA RUN DRIVE

CAMPO AVENUE

ALERION STREET

ALERION STREET

ESCONDIDO CANYON STREET

LONE POINT COURT

COPPER FOUNTAIN STREET

CARRIAGE HILLS DRIVE

HILLS DRIVE

215
3 Plus Service Poles
#4 Wire
#2 Wire

