

AURORA VIEW ESTATES

Recorded in Book 88 Page 71 of Plats

200 Scale Map Location: Q-3-2

Fire Dept. District Map # 2518:32A-B; 42B

MASTER SITE ADDRESS: 1518 S. TIOGA WAY

LOT	1	1516	MARBELLA RIDGE CT	N/S	PRIVATE STREET
	2	1508			
	3	1500			
	4	1416			
	5	1408			
	6	1400			
	7	1401			
	8	1409			
	9	1417			
	10	1501			
	11	1509			
	12	1517			
	13	1609			
	14	1617			
	15	1625			
	16	1633			
	17	1632			
	18	1624			
	19	1616			
	20	1608			
	21	1600			
Common Area	A		PRIVATE ST	N/S	PRIVATE STREET
Common Area	B	1603	MARBELLA RIDGE CT	N/S	PRIVATE STREET

ORIGINAL DATE: 3/08/1999

CITY OF LAS VEGAS
PLANNING & DEVELOPMENT DEPARTMENT



SEAN ROBERTSON, PLANNER I

AURORA VIEW ESTATES

Recorded in Book 88 Page 71 of Plats

200 Scale Map Location: Q-3-2


Fire Dept. District Map # 2518:32A-B; 42B

MASTER SITE ADDRESS: 1518 S. TIOGA WAY

LOT	1	1516	MARBELLA RIDGE CT	N/S	PRIVATE STREET
	2	1508			
	3	1500			
	4	1416			
	5	1408			
	6	1400			
	7	1401			
	8	1409			
	9	1417			
	10	1501			
	11	1509			
	12	1517			
	13	1609			
	14	1617			
	15	1625			
	16	1633			
	17	1632			
	18	1624			
	19	1616			
	20	1608			
	21	1600			
Common Area	A		PRIVATE ST	N/S	PRIVATE STREET
Common Area	B	1603	MARBELLA RIDGE CT	N/S	PRIVATE STREET

ORIGINAL DATE: 3/08/1999

CITY OF LAS VEGAS
PLANNING & DEVELOPMENT DEPARTMENT

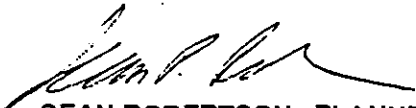

SEAN ROBERTSON, PLANNER I

AURORA VIEW ESTATES

Recorded in Book 88 Page 71 of Plats

200 Scale Map Location: Q-3-2


Fire Dept. District Map # 2518:32A-B; 42B

MASTER SITE ADDRESS: 1518 S. TIOGA WAY

LOT	1	1516	MARBELLA RIDGE CT	N/S	PRIVATE STREET
	2	1508			
	3	1500			
	4	1416			
	5	1408			
	6	1400			
	7	1401			
	8	1409			
	9	1417			
	10	1501			
	11	1509			
	12	1517			
	13	1609			
	14	1617			
	15	1625			
	16	1633			
	17	1632			
	18	1624			
	19	1616			
	20	1608			
	21	1600			
Common Area	A		PRIVATE ST	N/S	PRIVATE STREET
Common Area	B	1603	MARBELLA RIDGE CT	N/S	PRIVATE STREET

ORIGINAL DATE: 3/08/1999

CITY OF LAS VEGAS
PLANNING & DEVELOPMENT DEPARTMENT

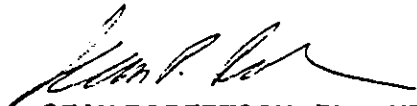
SEAN ROBERTSON, PLANNER I

When 2.3
Why don't we have
↓ an amended
recorded
plot?

LOTS 4, 5, AND 6 COMBINED INTO
TWO LOTS - 1408 & 1416 MARBELLA RD

Electric meter on entry island


Addressed 1522 MARBELLA RIDGE

by Sam Roberts 4-7-99

0.3-2

0137.3

GRAPHIC SCALE

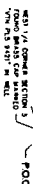

DEMOITS AUTOMATED FACILITY LINES
DEMOITS RADIAL LINE
DEMOITS SET TYPE IN MONUMENT
1 THROUGH 2 AND 17 THROUGH 31.

GOVERNMENT PATENT CASES

9471 2 0 2