

RANCHO ALTA MIRA
LOT 11 - UNIT 0

APRIL 19, 1993

FIRE MAP #1821::29,39
2DD MAP: L-1-2,4

BLOCK 2 LOT 19 4909 VIRGINIA FALLS LANE E/W PUBLIC STREET
 20 4905
 21 49D1
 22 4813
 23 48D9
 24 4805
 25 4801

BLOCK 4 LOT 17 4704 STANDING BLUFF WAY N/S PUBLIC STREET
 18 4700
 19 4640
 20 4636
 21 4632
 22 4628 NOT A PART
 23 4624
 24 4620
 25 4616
 26 4612
 27 4608
 28 4604
 29 4600 THIS PORTION HAS BEEN AMENDED

BLOCK 5 LOT 22 49D8 VIRGINIA FALLS LANE E/W PUBLIC STREET
 23 49D4

BLOCK 5 LOT 24 4601 SNOWPOINT COURT N/S PUBLIC STREET
 25 46D5
 26 4609
 27 4608
 28 4604
 29 4600

BLOCK 5 LOT 30 4609 STANDING BLUFF WAY N/S PUBLIC STREET
 31 4613
 32 4617

BLOCK 5 LOT 33 4801 FOXWARREN COURT E/W PUBLIC STREET
 34 4805
 35 48D9
 36 4813
 37 4817
 38 4816
 39 4812
 40 4808
 41 4804
 42 4800

BLOCK 5 LOT 43 4801 COURTFIELD CIRCLE E/W PUBLIC STREET
 44 4805
 45 4809
 46 4813
 47 4812
 48 4808
 49 4804
 50 4800

STREET WITH NO ADDRESSES: DECATUR BOULEVARD N/S PUBLIC STREET

CITY OF LAS VEGAS
DEPARTMENT OF COMMUNITY
PLANNING & DEVELOPMENT

 MATT PIHJUV, PLANNER


MP/dr

MASTER SUBDIVISION ADDRESS: 4631 STANDING BLUFF WAY

SEE THE LIST FOR AMENDED MAP OF RANCHO ALTA MIRA LOT 11 - UNIT B
(dated October 14, 1993)

RANCHO ALTA MIRA - LOT 11

UNIT B

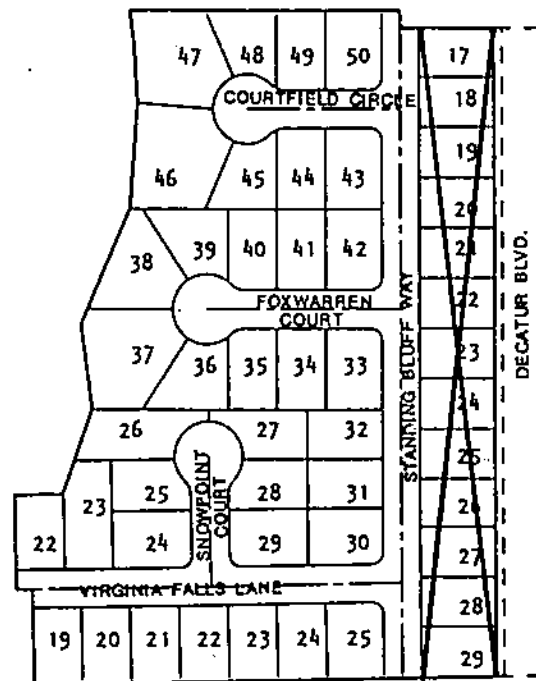

RANCHO ALTA MIRA
LOT 11 - UNIT B

APRIL 19, 1993

FIRE MAP #1821::29,39
200 MAP: L-1-2,4

BLOCK 2 LOT 19 4909 VIRGINIA FALLS LANE E/W PUBLIC STREET
 20 4905
 21 4901
 22 4813
 23 4809
 24 4805
 25 4801

BLOCK 4 LOT 17 4704 STANDING BLUFF WAY N/S PUBLIC STREET
 18 4700
 19 4640
 20 4636
 21 4632
 22 4628 NOT A PART
 23 4624
 24 4620
 25 4616
 26 4612
 27 4608
 28 4604
 29 4600 THIS PORTION HAS BEEN AMENDED

BLOCK 5 LOT 22 4908 VIRGINIA FALLS LANE E/W PUBLIC STREET
 23 4904

BLOCK 5 LOT 24 4601 SNOWPOINT COURT N/S PUBLIC STREET
 25 4605
 26 4609
 27 4608
 28 4604
 29 4600

BLOCK 5 LOT 30 4609 STANDING BLUFF WAY N/S PUBLIC STREET
 31 4613
 32 4617

BLOCK 5 LOT 33 4801 FOXWARREN COURT E/W PUBLIC STREET
 34 4805
 35 4809
 36 4813
 37 4817
 38 4816
 39 4812
 40 4808
 41 4804
 42 4800

BLOCK 5 LOT 43 4801 COURTFIELD CIRCLE E/W PUBLIC STREET
 44 4805
 45 4809
 46 4813
 47 4812
 48 4808
 49 4804
 50 4800

STREET WITH NO ADDRESSES: DECATUR BOULEVARD N/S PUBLIC STREET

CITY OF LAS VEGAS
DEPARTMENT OF COMMUNITY
PLANNING & DEVELOPMENT

MP MATT PINJUV, PLANNER


MP/dr

MASTER SUBDIVISION ADDRESS: 4631 STANDING BLUFF WAY

SEE THE LIST FOR AMENDED MAP OF RANCHO ALTA MIRA LOT 11 - UNIT B
(dated October 14, 1993)

RANCHO ALTA MIRA - LOT 11

UNIT B

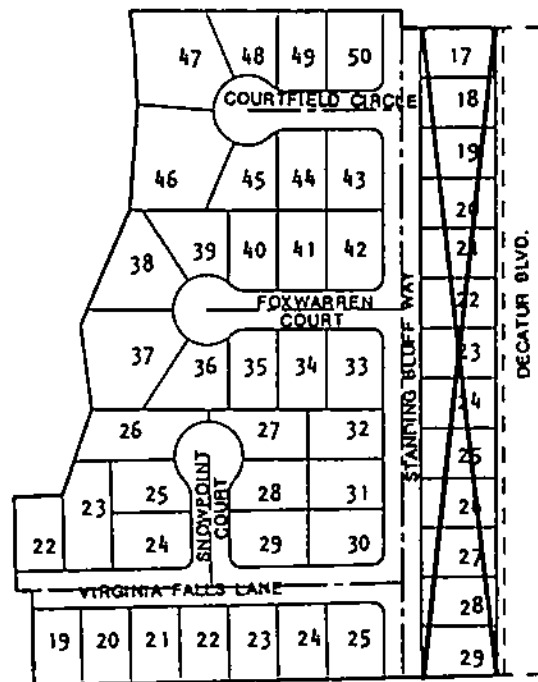

RANCHO ALTA MIRA
LOT 11 - UNIT B

APRIL 19, 1993

FIRE MAP #1821::29,39
200 MAP: L-1-2,4

=====

BLOCK 2	LOT	19	4909	VIRGINIA FALLS LANE	E/W	PUBLIC STREET
		20	4905			
		21	4901			
		22	4813			
		23	4809			
		24	4805			
		25	4801			

BLOCK 4	LOT	17	4704	STANDING BLUFF WAY	N/S	PUBLIC STREET
		18	4700			
		19	4640			
		20	4636			
		21	4632			
		22	4628	NOT A PART		
		23	4624			
		24	4620			
		25	4616			
		26	4612			
		27	4608			
		28	46D4			
		29	46DD	THIS PORTION HAS BEEN AMENDED		

BLOCK 5	LOT	22	4908	VIRGINIA FALLS LANE	E/W	PUBLIC STREET
		23	4904			

BLOCK 5	LOT	24	4601	SNOWPOINT COURT	N/S	PUBLIC STREET
		25	4605			
		26	4609			
		27	4608			
		28	4604			
		29	4600			

BLOCK 5	LOT	30	4609	STANDING BLUFF WAY	N/S	PUBLIC STREET
		31	4613			
		32	4617			

BLOCK 5	LOT	33	4801	FOXWARREN COURT	E/W	PUBLIC STREET
		34	4805			
		35	4809			
		36	4813			
		37	4817			
		38	4816			
		39	4812			
		40	4808			
		41	4804			
		42	4800			

BLOCK 5	LOT	43	4801	COURTFIELD CIRCLE	E/W	PUBLIC STREET
		44	4805			
		45	4809			
		46	4813			
		47	4812			
		48	4808			
		49	4804			
		50	4800			

STREET WITH NO ADDRESSES:	DECATUR BOULEVARD	N/S	PUBLIC STREET
---------------------------	-------------------	-----	---------------

CITY OF LAS VEGAS
DEPARTMENT OF COMMUNITY
PLANNING & DEVELOPMENT

 MATT PINJUV, PLANNER


MP/dr

MASTER SUBDIVISION ADDRESS: 4631 STANDING BLUFF WAY

SEE THE LIST FOR AMENDED MAP OF RANCHO ALTA MIRA LOT 11 - UNIT B
(dated October 14, 1993)


RANCHO ALTA MIRA - LOT 11

UNIT B

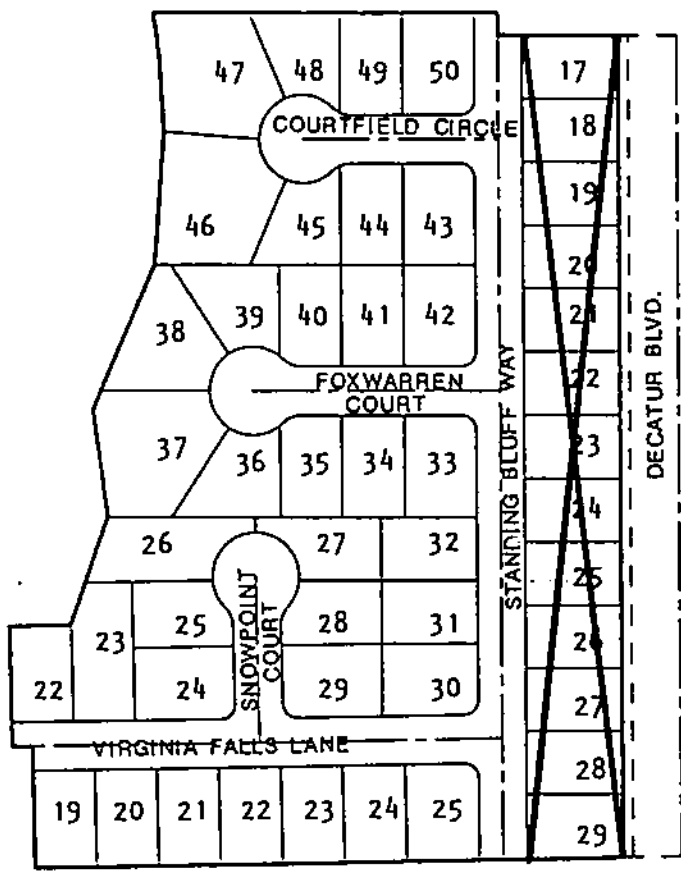

RANCHO ALTA MIRA - LOT 11

UNIT B

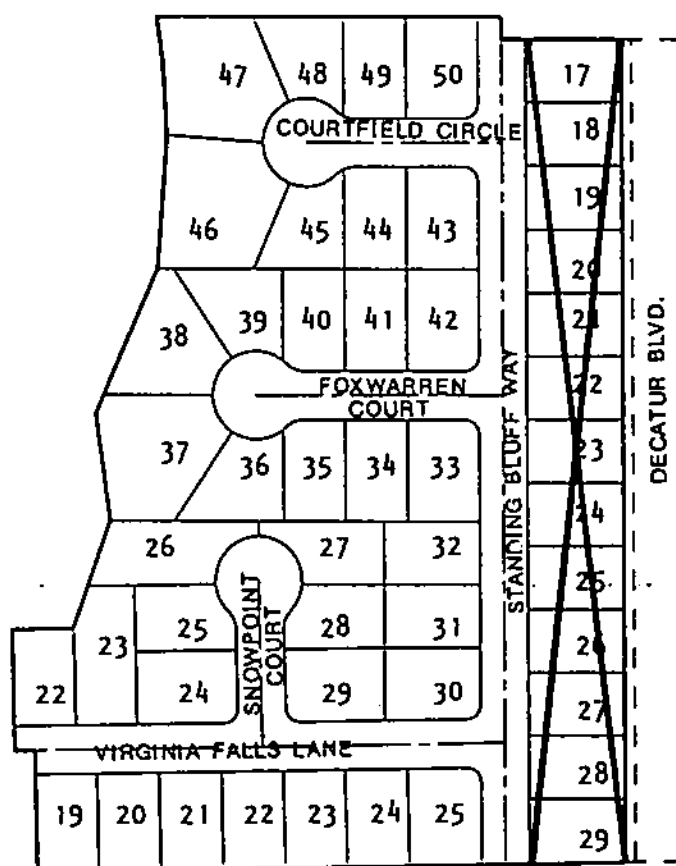

RANCHO ALTA MIRA
LOT 11 - UNIT B

APRIL 19, 1993

FIRE MAP #1821::29,39
200 MAP: L-1-2,4

=====

BLOCK 2	LOT	19	4909	VIRGINIA FALLS LANE	E/W	PUBLIC STREET
		20	4905			
		21	4901			
		22	4813			
		23	4809			
		24	4805			
		25	4801			

BLOCK 4	LOT	17	4704	STANDING BLUFF WAY	N/S	PUBLIC STREET
		18	4700			
		19	4640			
		20	4636			
		21	4632			
		22	4628	NOT A PART		
		23	4624			
		24	4620			
		25	4616			
		26	4612			
		27	4608			
		28	4604			
		29	4600	THIS PORTION HAS BEEN AMENDED		

BLOCK 5	LOT	22	4908	VIRGINIA FALLS LANE	E/W	PUBLIC STREET
		23	4904			

BLOCK 5	LOT	24	4601	SNOWPOINT COURT	N/S	PUBLIC STREET
		25	4605			
		26	4609			
		27	4608			
		28	4604			
		29	4600			

BLOCK 5	LOT	30	4609	STANDING BLUFF WAY	N/S	PUBLIC STREET
		31	4613			
		32	4617			

BLOCK 5	LOT	33	4801	FOXWARREN COURT	E/W	PUBLIC STREET
		34	4805			
		35	4809			
		36	4813			
		37	4817			
		38	4816			
		39	4812			
		40	4808			
		41	4804			
		42	4800			

BLOCK 5	LOT	43	4801	COURTFIELD CIRCLE	E/W	PUBLIC STREET
		44	4805			
		45	4809			
		46	4813			
		47	4812			
		48	4808			
		49	4804			
		50	4800			

STREET WITH NO ADDRESSES:	DECATUR BOULEVARD	N/S	PUBLIC STREET
---------------------------	-------------------	-----	---------------

CITY OF LAS VEGAS
DEPARTMENT OF COMMUNITY
PLANNING & DEVELOPMENT

MP MATT PINJUV, PLANNER

MP/dr

MASTER SUBDIVISION ADDRESS: 4631 STANDING BLUFF WAY

SEE THE LIST FOR AMENDED MAP OF RANCHO ALTA MIRA LOT 11 - UNIT B
(dated October 14, 1993)