

IRON MOUNTAIN/JONES UNIT 5

Recorded in Book 119 Page 066 of Plats

MASTER SITE ADDRESS: 5758 GILBERT LN

Fire Department District Map Number:

01221-74

<u>Block</u>	<u>Lot</u>	<u>Address</u>
A	CE-F	9024 SAWHILL POND ST
	1	5761 MINERAL ROCK AVE
	2	5765
	3	5769
	4	9009 SANDSTONE RAVINE ST
	5	9013
	6	9017
	7	9021
	8	9025
	9	9101
	10	9105
	11	9109
	12	9113
	13	9117
	14	9108
	15	9104
	16	9100
	17	5764 BEDROCK SPRINGS AVE
	18	5760
	19	5756
	20	9020 SAWHILL POND ST
	21	9016
	22	9012
	23	9008
	24	5749 MINERAL ROCK AVE
	25	5753
B	26	5752
	27	5756
	28	5760
	29	5764

IRON MOUNTAIN/JONES UNIT 5


Recorded in Book 119 Page 066 of Plats

MASTER SITE ADDRESS: 5758 GILBERT LN

Fire Department District Map Number:

01221-74

<u>Block</u>	<u>Lot</u>	<u>Address</u>
B	30	5768 MINERAL ROCK AVE
	31	5769 BEDROCK SPRINGS AVE
	32	5765
	33	5761
	34	5757
	35	5753

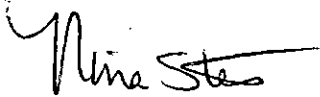

Nina Stevens, Planner I

R-PD3











































DETENTION BASIN

SNC-5832 (Street Name Change)

From: GILBERT LANE To: SHELEHEDA AVE.

between JONES BLVD. and BRADLEY RD.

BRADLEY RD

R-PD7

R-PD7

12/15/04

STREET NAME CHANGE
FROM GILBERT LANE
TO SHELEHEDA
AVENUE

CHANGE NAME ON
THIS MAP


SNC-5832

PC-1/22/05

NOTES


**FINAL MAP OF
IRON MOUNTAIN & JONES UNIT 5**
A COMMON INTEREST COMMUNITY
BEING A SUBDIVISION OF A PORTION OF THE WEST HALF
OF THE NORTHEAST QUARTER ONE 1/4I OF THE
SOUTHWEST QUARTER 1SW 1/4I OF SECTION 1, TOWNSHIP
19 SOUTH, RANGE 60 EAST, M.D.M. CITY OF LAS VEGAS,
CLARK COUNTY, NEVADA.

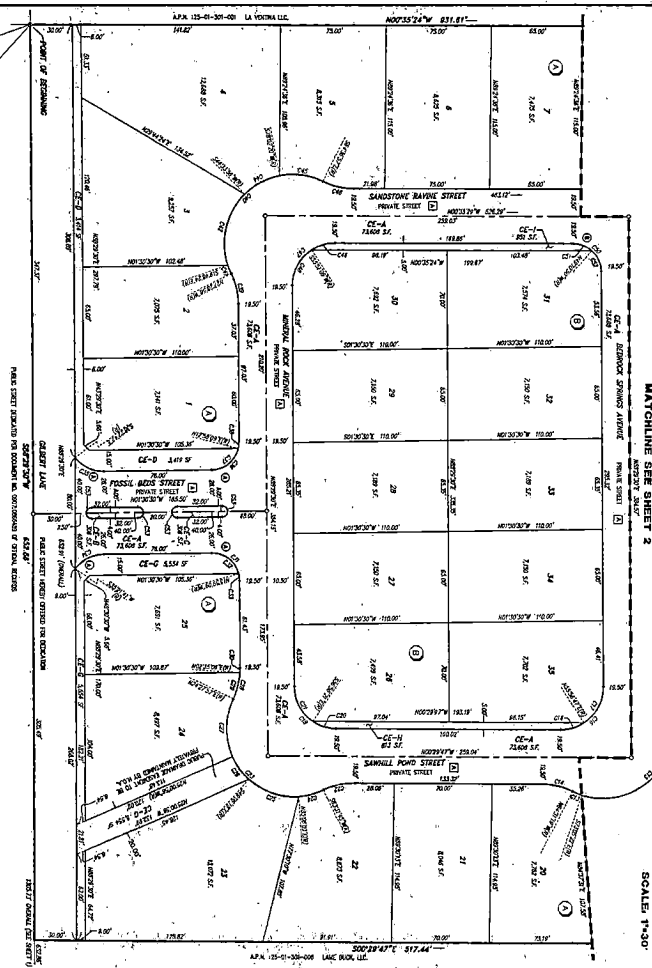

SCALE, 1"=30'

BOUNDARY LINE
STREET CORNER




Carter-Burgess

60506 Barruda Road
Las Vegas, Nevada 89119
(702) 608-6400