

PECCOLE WEST - LOT 11

Recorded in Book 77 Page 31 of Plats

200 Scale Map Location: L-31-5, 6

Fire Dept. District Map # 2415:65, 66, 67, 72, 73,

MASTER SITE ADDRESS: 599 PALACE CT

BLOCK A	LOT	1	9511	KINGS GATE CT	E/W	PRIVATE STREET
		2	9505			
		3	9501			
		4	9409			
		5	9405			
		6	9401			
		7	9400			
		8	9404			
		9	9408			
		10	9500			
		11	9504			
		12	9508			
BLOCK A	LOT	13	9700	WINTER PALACE DR	E/W	PRIVATE STREET
		14	9704			
		15	9708			
		16	9712			
		17	9716			
		18	9720			
		19	9800			
		20	9804			
		21	9808			
		22	9812			
		23	9816			
		24	9820			
		25	9824			
		26	9828			
		27	9825			
		28	9821			
		29	9817			
		30	9813			
		31	9809			
		32	9805			
		33	9801			
		34	9721			
		35	9717			
		36	9713			
		37	9709			
		38	9705			
		39	9701			
BLOCK A	LOT	40	605	QUEENSRIDGE CT	N/S	PRIVATE STREET
		41	601			
		42	600			
		43	604			
		44	608			
Common Area	B	9513	KINGS GATE CT	E/W	PRIVATE STREET	
	B-1	9399				

PECCOLE WEST - LOT 11

Common Area	B-2	9827	WINTER PALACE DR	E/W	PRIVATE STREET
Common Area	C	9510	KINGS GATE CT	E/W	PRIVATE STREET

ORIGINAL DATE: 12/12/1996

**CITY OF LAS VEGAS
PLANNING & DEVELOPMENT DEPARTMENT**



UPDATED 2/6/02-DAVID R BRATCHER, SR PLANNER

PECCOLE WEST - LOT 11

Recorded in Book 77 Page 31 of Plats

200 Scale Map Location: L-31-5, 6

Fire Dept. District Map # 2415:65, 66, 67, 72, 73,

MASTER SITE ADDRESS: 599 PALACE CT

BLOCK A	LOT	1	9511	KINGS GATE CT	E/W	PRIVATE STREET
		2	9505			
		3	9501			
		4	9409			
		5	9405			
		6	9401			
		7	9400			
		8	9404			
		9	9408			
		10	9500			
		11	9504			
		12	9508			
BLOCK A	LOT	13	9700	WINTER PALACE DR	E/W	PRIVATE STREET
		14	9704			
		15	9708			
		16	9712			
		17	9716			
		18	9720			
		19	9800			
		20	9804			
		21	9808			
		22	9812			
		23	9816			
		24	9820			
		25	9824			
		26	9828			
		27	9825			
		28	9821			
		29	9817			
		30	9813			
		31	9809			
		32	9805			
		33	9801			
		34	9721			
		35	9717			
		36	9713			
		37	9709			
		38	9705			
		39	9701			
BLOCK A	LOT	40	605	QUEENSRIDGE CT	N/S	PRIVATE STREET
		41	601			
		42	600			
		43	604			
		44	608			
Common Area	B	9513	KINGS GATE CT	E/W	PRIVATE STREET	
	B-1	9399				

PECCOLE WEST - LOT 11

Common Area	B-2	9827	WINTER PALACE DR	E/W	PRIVATE STREET
Common Area	C	9510	KINGS GATE CT	E/W	PRIVATE STREET

ORIGINAL DATE: 12/12/1996

**CITY OF LAS VEGAS
PLANNING & DEVELOPMENT DEPARTMENT**



UPDATED 2/6/02-DAVID R BRATCHER, SR PLANNER

PECCOLE WEST - LOT 11

Recorded in Book 77 Page 31 of Plats

200 Scale Map Location: L-31-5, 6

Fire Dept. District Map # 2415:65, 66, 67, 72, 73,

MASTER SITE ADDRESS: 599 PALACE CT

BLOCK A	LOT	1	9511	KINGS GATE CT	E/W	PRIVATE STREET
		2	9505			
		3	9501			
		4	9409			
		5	9405			
		6	9401			
		7	9400			
		8	9404			
		9	9408			
		10	9500			
		11	9504			
		12	9508			
BLOCK A	LOT	13	9700	WINTER PALACE DR	E/W	PRIVATE STREET
		14	9704			
		15	9708			
		16	9712			
		17	9716			
		18	9720			
		19	9800			
		20	9804			
		21	9808			
		22	9812			
		23	9816			
		24	9820			
		25	9824			
		26	9828			
		27	9825			
		28	9821			
		29	9817			
		30	9813			
		31	9809			
		32	9805			
		33	9801			
		34	9721			
		35	9717			
		36	9713			
		37	9709			
		38	9705			
		39	9701			
BLOCK A	LOT	40	605	QUEENSRIDGE CT	N/S	PRIVATE STREET
		41	601			
		42	600			
		43	604			
		44	608			
Common Area	B	9513	KINGS GATE CT	E/W	PRIVATE STREET	
	B-1	9399				

PECCOLE WEST - LOT 11

Common Area	B-2	9827	WINTER PALACE DR	E/W	PRIVATE STREET
Common Area	C	9510	KINGS GATE CT	E/W	PRIVATE STREET

ORIGINAL DATE: 12/12/1996

**CITY OF LAS VEGAS
PLANNING & DEVELOPMENT DEPARTMENT**



UPDATED 2/6/02-DAVID R BRATCHER, SR PLANNER

PECCOLE WEST - LOT 11

Recorded in Book 77 Page 31 of Plats

200 Scale Map Location: L-31-5, 6

Fire Dept. District Map # 2415:65, 66, 67, 72, 73,

MASTER SITE ADDRESS: 599 PALACE CT

BLOCK A	LOT	1	9511	KINGS GATE CT	E/W	PRIVATE STREET
		2	9505			
		3	9501			
		4	9409			
		5	9405			
		6	9401			
		7	9400			
		8	9404			
		9	9408			
		10	9500			
		11	9504			
		12	9508			
BLOCK A	LOT	13	9700	WINTER PALACE DR	E/W	PRIVATE STREET
		14	9704			
		15	9708			
		16	9712			
		17	9716			
		18	9720			
		19	9800			
		20	9804			
		21	9808			
		22	9812			
		23	9816			
		24	9820			
		25	9824			
		26	9828			
		27	9825			
		28	9821			
		29	9817			
		30	9813			
		31	9809			
		32	9805			
		33	9801			
		34	9721			
		35	9717			
		36	9713			
		37	9709			
		38	9705			
		39	9701			
BLOCK A	LOT	40	605	QUEENSRIDGE CT	N/S	PRIVATE STREET
		41	601			
		42	600			
		43	604			
		44	608			
Common Area	B	9513	KINGS GATE CT	E/W	PRIVATE STREET	
	B-1	9399				

PECCOLE WEST - LOT 11

Common Area	B-2	9827	WINTER PALACE DR	E/W	PRIVATE STREET
Common Area	C	9510	KINGS GATE CT	E/W	PRIVATE STREET

ORIGINAL DATE: 12/12/1996

**CITY OF LAS VEGAS
PLANNING & DEVELOPMENT DEPARTMENT**



UPDATED 2/6/02-DAVID R BRATCHER, SR PLANNER

Keep in file

PECCOLE WEST LOT 11

Recorded in Book 77 Page 31 of Plats

200 Scale Map Location: L-31-5, 6

Fire Dept. District Map # 2415:65, 66, 67, 72, 73,

MASTER SITE ADDRESS: 599 PALACE CT

BLOCK A LOT 1 ~~600~~ **9511 KINGS GATE CT** PALACE CT N/S PRIVATE STREET
BLOCK A LOT 2 9505 KINGS GATE CT EW PRIVATE STREET

3 9501
4 9409
5 9405
6 9401
7 9400
8 9404
9 9408
10 9500
11 9504
12 9508

BLOCK A LOT 13 9700 WINTER PALACE DR EW PRIVATE STREET

14 9704
15 9708
16 9712
17 9716
18 9720
19 9800
20 9804
21 9808
22 9812
23 9816
24 9820
25 9824
26 9828
27 9825
28 9821
29 9817
30 9813
31 9809
32 9805
33 9801
34 9721
35 9717
36 9713
37 9709
38 9705
39 9701

UPDATE 4/22/97

QUEENRIDGE CT. has
been changed to:

QUEENSRIDGE CT. by
CERTIFICATE of
AMENDMENT
recorded 4-15-97

BLOCK A LOT 40 605 QUEENRIDGE CT N/S PRIVATE STREET
41 601 QUEENSRIDGE CT
42 600
43 604
44 608

Common Area B ~~9511~~ **9513 KINGS GATE CT** EW PRIVATE STREET
B-1 9399


Common Area B-2 9827 WINTER PALACE DR EW PRIVATE STREET

Common Area C 9510 KINGS GATE CT EW PRIVATE STREET

CITY OF LAS VEGAS
PLANNING & DEVELOPMENT DEPARTMENT

KW
KYLE C WALTON, SENIOR PLANNER


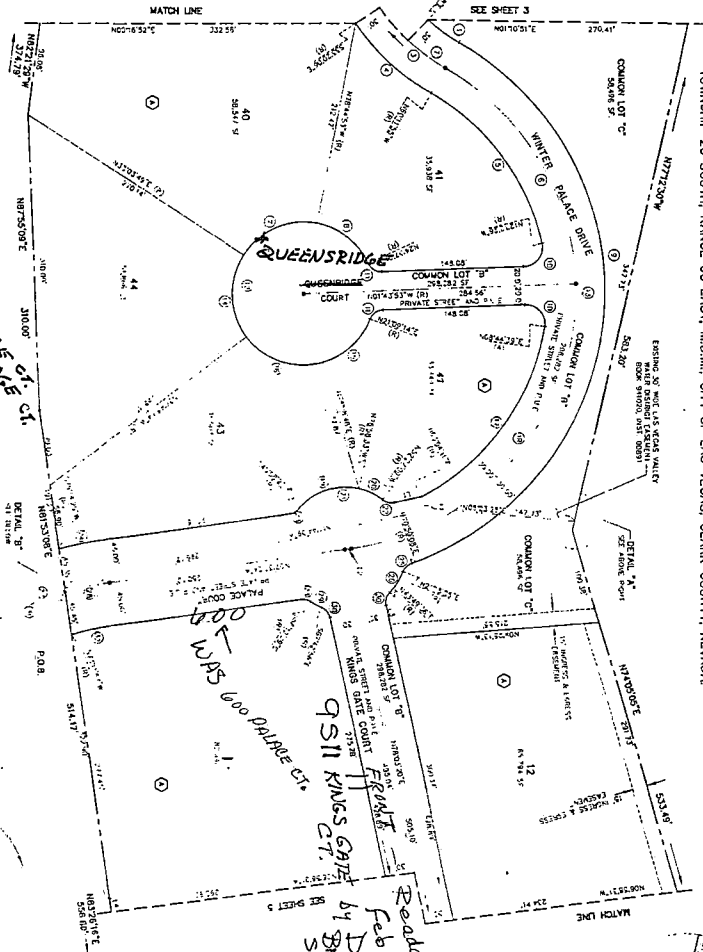[illegible]

Addressed
Feb. 4, 2002
by David R.
BRATCHEE,
SR. PLANNER

LOT 11 OF BOOK 11, PAGE 23 OF PLATS - LYING WITHIN THE SOUTH HALF (S 1/2) OF SECTION 31, TOWNSHIP 20 SOUTH, RANGE 60 EAST, M.O.M., CITY OF LAS VEGAS, CLARK COUNTY, NEVADA.

© MONUMENTAL

- CENTER LINE POINT OF INTERSECTION

5.V.R.E.(SOFT VISIBILITY RESTRICTION-FAVORABLE)

IMPROVEMENTS INTRODUCED 30 INCHES
ALLOWED WITHIN THE AREA'S SPECIFICATIONS


LOT NUMBER





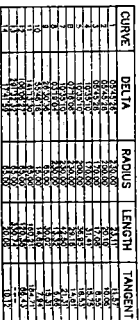


NOTES

- LOT 8 = 605 AC. (TOTAL AREA)

LOT 11 OF BOOK 11, PAGE 23 OF PLATS - LYING WITHIN THE SOUTH HALF (S 1/2) OF SECTION 31, TOWNSHIP 20 SOUTH, RANGE 60 EAST, M.D.M., CITY OF LAS VEGAS, CLARK COUNTY, NEVADA.



- NOTES
4. LOT "B" = 0.03 AC. (TOTAL AREA)

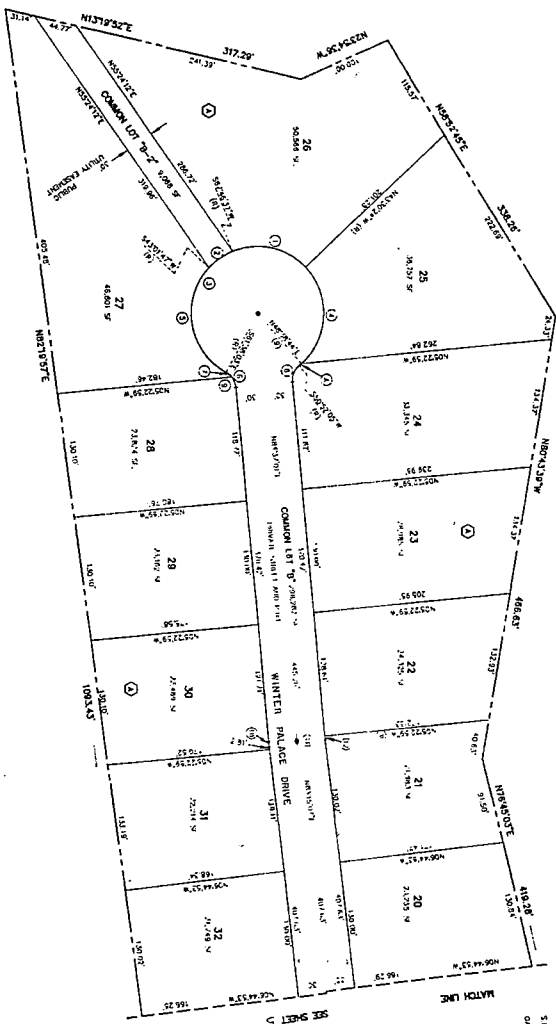



LOT 11 OF BOOK 11, PAGE 21 OF PLATS - LYING WITHIN THE SOUTH HALF (S 1/2) OF SECTION 31, TOWNSHIP 20 SOUTH, RANGE 60 EAST, M.D.M. CITY OF LAS VEGAS, CLARK COUNTY, NEVADA.



117

- [illegible]

FOUND MONUMENTATION

- (b) FOUND MONUMENTATION AS SHOWN AND DESCRIBED
- SET 9/0" RIGID AND ALUMINUM CAP STAMPED "P.L.S.541" WITH REFERENCE MONUMENTS IN TOP OF CURB (UNLESS OTHERWISE NOTED)

- CENTER LINE POINT OF INTERSECTION

- ~~S.V.R.C. (SIGHT VISIBILITY RESTRICTION ELEMENT)~~

- NO EXEMPTIONS ON THE BASIS OF IMPROVEMENTS WALKER THAT SO NO ALLOWED WITHIN THE AREAS 585656

- 9 LOT NUMBER
TOTAL LOTS IN SUBDIVISION = 44

- B
BLOCK NUMBER


- 14 CURVE NUMBER

- SECRET CONTINUING

- PROPRIETY LINE
- SQUANT TLET

- CA BYRNAL CURVE

LINE	BEARING	DISTANCE
1	N03°15'07"E	12.61
2	N01°15'02"E	6.74
3	N73°41'43"E	11.67
4	N00°54'08"W	14.18
5	N08°59'09"E	4.53

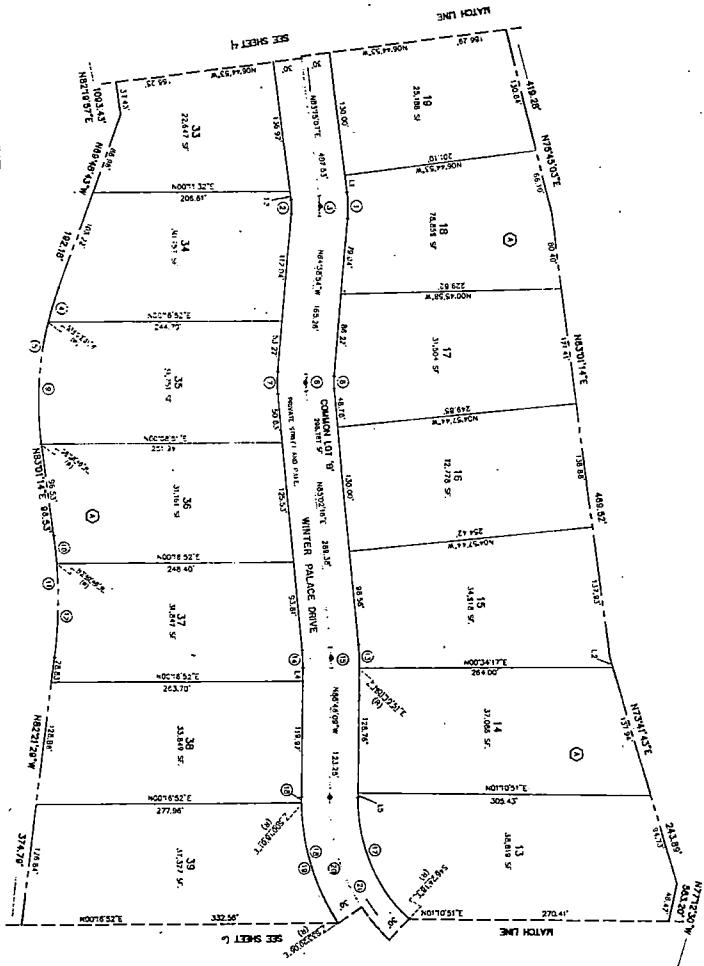



PENTACORE

Civil Engineering
Construction
Administration
Land Surveying
Global Positioning
GIS
Land Planning
ADA Consulting
Measurement
Technologies

CERTIFICATE OF AMENDMENT
of
PECCOLE WEST - LOT 11

Project Number: 0145.0026

Date: March 27, 1997

Rita Lumos, P.L.S.
City of Las Vegas Surveyor
400 E. Stewart Avenue
Las Vegas, NV 89101

DOCUMENT: Peccole West - Lot 11
Book 77, Page 31 of Plats

LEGAL DESCRIPTION:


Lot 11 of Book 77, Page 23 of Plats - Lying within the South Half (S 1/2) of Section 31, Township 20 South, Range 60 East, M.D.M., City of Las Vegas, Clark County, Nevada.

RECORDING DATE: December 12, 1996

CAPTION:

On sheet 6 of 7, Queenridge Court was annotated in error. It should read Queensridge Court.

This document supercedes all previous documents.

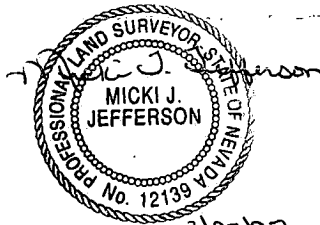

Micki J. Jefferson
Professional Land Surveyor
Nevada Certificate No. 12139

I hereby certify that I have examined the Certificate of Amendment and that the changes to the original document specified therein are provided for in applicable sections of NRS 278.010 to 278.630, inclusive, NRS 625.340 to 625.380, inclusive, and local ordinances adopted pursuant thereto, and I am satisfied that this Certificate of Amendment so amends or corrects the document as to make it technically correct.

Rita Lumos

4/10/97

Rita Lumos, P.L.S.
City of Las Vegas Surveyor
Nevada Certificate No. 5094

