

SUMMERLIN VILLAGE 11/12 CANYON VISTA

Recorded in Book 77 Page 67 of Plats

200 Scale Map Location: K-36-4

Fire Dept. District Map # 2414:58, 59

MASTER SITE ADDRESS: 603 S. HUALAPAI WAY

BLOCK A	LOT	1	10104	CRESENT MESA LN	E/W	PRIVATE STREET
		2	10100			
		3	10016			
		4	10012			
		5	10008			
		6	10004			
		7	10000			
		8	10001			
		9	10005			
		10	10009			
		11	10013			
		12	10017			
BLOCK A	LOT	13	10016	BOW RIDGE CT	E/W	PRIVATE STREET
		14	10012			
		15	10008			
		16	10004			
		17	10000			
		18	10001			
		19	10005			
		20	10009			
BLOCK A	LOT	21	612	EDGEBROOK DR	N/S	PRIVATE STREET
		22	616			
		23	624			
		24	628			
		25	636			
		26	637			
		27	633			
		28	629			
		29	625			
		30	621			
		31	617			
		32	613			
		33	609			
		34	605			
		35	601			
BLOCK A	LOT	36	600	VERDE VISTA PL	N/S	PRIVATE STREET
		37	604			
		38	808			
BLOCK A	LOT	39	10113	EDGECLIFF LN	E/W	PRIVATE STREET
		40	10117			
		41	10121			
		42	10201			
		43	10205			
		44	10209			
		45	10208			
		46	10204			
BLOCK A	LOT	47	613	HERMOSA CANYON DR	N/S	PRIVATE STREET
		48	609			
		49	605			


BLOCK A	LOT	50	601	HERMOSA CANYON DR	N/S	PRIVATE STREET
BLOCK A	LOT	51	10208	CRESENT MESA LN	E/W	PRIVATE STREET
		52	10204			
		53	10200			
		54	10120			
		55	10116			
		56	10112			
BLOCK B	LOT	57	604	HERMOSA CANYON DR	N/S	PRIVATE STREET
BLOCK B	LOT	58	601	VERDE VISTA PL	N/S	PRIVATE STREET
		59	605			
		60	609			
		61	613			
BLOCK B	LOT	62	616	HERMOSA CANYON DR	N/S	PRIVATE STREET
		63	612			
		64	608			
Common Area	A		10019 W	ALTA DR	E/W	PUBLIC STREET
Common Area	B		10106	CRESENT MESA LN	E/W	PRIVATE STREET
	C		9999			
Common Area	D		610	VERDE VISTA PL	N/S	PRIVATE STREET
Common Area	E		9999	BOW RIDGE CT	E/W	PRIVATE STREET
Common Area	F		639	EDGEBROOK DR	N/S	PRIVATE STREET
Common Area	G		10211	EDGECLIFF LN	E/W	PRIVATE STREET
Common Area	H		10110	CRESENT MESA LN	E/W	PRIVATE STREET
Common Area	I		10203 W	ALTA DR	E/W	PUBLIC STREET
Common Area	J		596	LEDGESTONE PL	N/S	PRIVATE STREET
	K		598			

ORIGINAL DATE: 1/10/1997

CITY OF LAS VEGAS
PLANNING & DEVELOPMENT DEPARTMENT



KYLE C WALTON, SENIOR PLANNER

SUMMERLIN VILLAGE 11/12 CANYON VISTA

Recorded in Book 77 Page 67 of Plats

200 Scale Map Location: K-36-4

Fire Dept. District Map # 2414:58, 59

MASTER SITE ADDRESS: 603 S. HUALAPAI WAY

BLOCK A	LOT	1	10104	CRESENT MESA LN	E/W	PRIVATE STREET
		2	10100			
		3	10016			
		4	10012			
		5	10008			
		6	10004			
		7	10000			
		8	10001			
		9	10005			
		10	10009			
		11	10013			
		12	10017			
BLOCK A	LOT	13	10016	BOW RIDGE CT	E/W	PRIVATE STREET
		14	10012			
		15	10008			
		16	10004			
		17	10000			
		18	10001			
		19	10005			
		20	10009			
BLOCK A	LOT	21	612	EDGEBROOK DR	N/S	PRIVATE STREET
		22	616			
		23	624			
		24	628			
		25	636			
		26	637			
		27	633			
		28	629			
		29	625			
		30	621			
		31	617			
		32	613			
		33	609			
		34	605			
		35	601			
BLOCK A	LOT	36	600	VERDE VISTA PL	N/S	PRIVATE STREET
		37	604			
		38	608			
BLOCK A	LOT	39	10113	EDGECLIFF LN	E/W	PRIVATE STREET
		40	10117			
		41	10121			
		42	10201			
		43	10205			
		44	10209			
		45	10208			
		46	10204			
BLOCK A	LOT	47	613	HERMOSA CANYON DR	N/S	PRIVATE STREET
		48	609			
		49	605			

SUMMITLIN VILLAGE 11/12 CANYON VISTA

BLOCK A	LOT	50	601	HERMOSA CANYON DR	N/S	PRIVATE STREET
BLOCK A	LOT	51	10208	CRESENT MESA LN	E/W	PRIVATE STREET
		52	10204			
		53	10200			
		54	10120			
		55	10116			
		56	10112			
BLOCK B	LOT	57	604	HERMOSA CANYON DR	N/S	PRIVATE STREET
BLOCK B	LOT	58	601	VERDE VISTA PL	N/S	PRIVATE STREET
		59	605			
		60	609			
		61	613			
BLOCK B	LOT	62	616	HERMOSA CANYON DR	N/S	PRIVATE STREET
		63	612			
		64	608			
Common Area	A		10019 W	ALTA DR	E/W	PUBLIC STREET
Common Area	B		10106	CRESENT MESA LN	E/W	PRIVATE STREET
	C		9999			
Common Area	D		610	VERDE VISTA PL	N/S	PRIVATE STREET
Common Area	E		9999	BOW RIDGE CT	E/W	PRIVATE STREET
Common Area	F		639	EDGEBROOK DR	N/S	PRIVATE STREET
Common Area	G		10211	EDGECLIFF LN	E/W	PRIVATE STREET
Common Area	H		10110	CRESENT MESA LN	E/W	PRIVATE STREET
Common Area	I		10203 W	ALTA DR	E/W	PUBLIC STREET
Common Area	J		596	LEDGESTONE PL	N/S	PRIVATE STREET
	K		598			

ORIGINAL DATE: 1/10/1997

CITY OF LAS VEGAS
PLANNING & DEVELOPMENT DEPARTMENT



KYLE C WALTON, SENIOR PLANNER

SUMMERLIN VILLAGE 11/12 CANYON VISTA AMENDED PORTION

Recorded in Book 80 Page 99 of Plats

200 Scale Map Location: K-36-4

Fire Dept. District Map # 2414:58

MASTER SITE ADDRESS: 607 S. HUALAPAI WAY


BLOCK A	LOT	8	10001	CRESENT MESA LN	E/W	PRIVATE STREET
BLOCK A	LOT	17	10000	BOW RIDGE CT	E/W	PRIVATE STREET
BLOCK A	LOT	45	10208	EDGECLIFF LN	E/W	PRIVATE STREET

"This Amended Final Map was filed to combine Common Lot "C" with Lot 8, Common Lot "E" with Lot 17 and Common Lot "G" with Lot 45 and grant necessary easements across same."

ORIGINAL DATE: 1/10/1997

AMENDED DATE: 8/13/1997

CITY OF LAS VEGAS
PLANNING & DEVELOPMENT DEPARTMENT

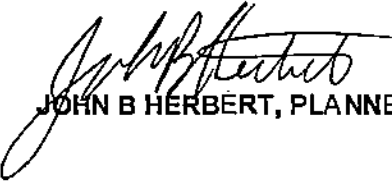
JOHN B HERBERT, PLANNER II

FOR Summerlin Village 11/12
Canyon Vista FILE
(Keep this in Original File - do not take)

This Subdivision has been AMENDED, Reducing lots 8, 17 & 45 ^{AREA of} 001590


SUMMERLIN VILLAGE 11/12 CANYON VISTA

A PLANNED RESIDENTIAL COMMUNITY

BEING A SUBDIVISION OF LOT 3 AND COMMON LOT 7¹ IN BLOCK 4 OF "THE ABERGORN AT SUMMERLIN VILLAGE 11/12 UNIT NO. 18" AS SHOWN BY MAP THEREON ON FILE IN BOOK 74, PAGE 71 OF PLATS IN THE CLARK COUNTY RECORDER'S OFFICE, CLARK COUNTY, NEVADA, LING WITHIN SECTION 36, TOWNSHIP 20 SOUTH, RANGE 59 EAST M.D.M., CITY OF LAS VEGAS, CLARK COUNTY, NEVADA


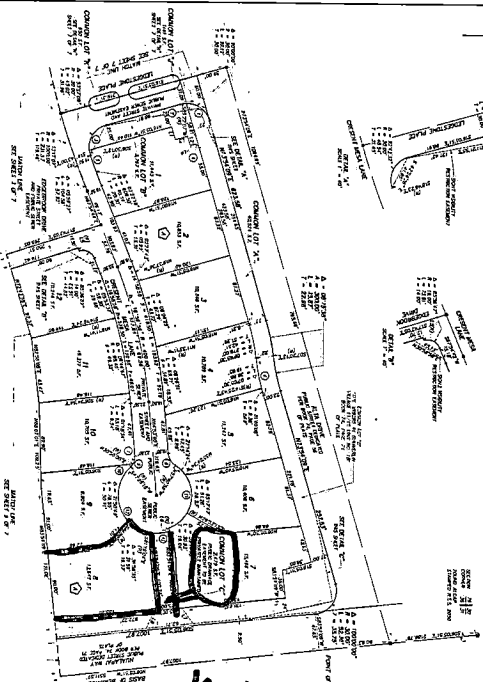

SEE AMENDED

- [illegible]

A PLANNED RESIDENTIAL COMMUNITY

A PLANNED RESIDENTIAL COMMUNITY BEING A SUBDIVISION OF LOT 3 AND COMMON LOT "D" IN BLOCK 4 OF "THE ARBORS AT SUMMERLIN VILLAGE 11/12 UNIT NO. 18" AS SHOWN BY MAP THEREOF ON FILE IN BOOK 74, PAGE 71 OF PLATS IN THE CLARK COUNTY RECORDER'S OFFICE, CLARK COUNTY, NEVADA, LYING WITHIN SECTION 35, TOWNSHIP 20 SOUTH, RANGE 39 EAST, M.D.M., CITY OF LAS VEGAS, CLARK COUNTY, NEVADA

LINE	BEARING	DISTANCE
1	81° 55' 00"	2.11
2	101° 55' 00"	1.00
3	101° 55' 00"	1.00
