

LAMPLIGHT VILLAGE AT CENTENNIAL SPRINGS UNIT 3

Recorded in Book 105 Page 8 of Plats

200 Scale Map Location: G-16-4

Fire Dept. District Map # 1417:36, 37

MASTER SITE ADDRESS: 7803 PALM GROVE LN

BLOCK 1	LOT	38	7914	EVENING SHADOWS	AVE	E/W	PRIVATE STREET
		39	7910				
		40	7906				
		41	7902				
		42	7848				
		43	7844				
		44	7840				
	*	45	7836				
		46	7832				
		47	7828				
		48	7824				
		49	7820				
		50	7816				
		51	7812				
		52	7808				
		53	7804				
		54	7800				
BLOCK 1	LOT	*55	7736	NATURES SONG ST		N/S	PRIVATE STREET
		56	7732				
		57	7728				
		58	7724				
		59	7720				
		60	7716				
		61	7712				
BLOCK 2	LOT	122	7915	EVENING SHADOWS	AVE	E/W	PRIVATE STREET
		123	7911				
		124	7907				
		125	7903				
		126	7845				
		127	7841				
		128	7837				
		129	7833				
		130	7829				
BLOCK 3	LOT	172	7821	EVENING SHADOWS	AVE	E/W	PRIVATE STREET
		173	7817				
		174	7813				
BLOCK 3	LOT	175	7729	NATURES SONG ST		N/S	PRIVATE STREET
		176	7725				
		177	7721				
		178	7717				
		179	7713				
BLOCK 3	LOT	184	7708	HIDDEN GAZEBO ST		N/S	PRIVATE STREET
		185	7712				
		186	7716				

* Re-Sub. / merger to "Lamplight Village - Unit 5"

LAMPLIGHT VILLAGE AT CENTENNIAL SPRINGS UNIT 3

BLOCK 3	LOT	187	7720	HIDDEN GAZEBO ST	N/S	PRIVATE STREET
		188	7724			
		189	7728			
BLOCK 4	LOT	134	7915	HIDDEN VILLAGE AVE	E/W	PRIVATE STREET
		135	7911			
		136	7907			
		137	7903			
		138	7845			
		139	7841			
		140	7837			
		141	7833			
		142	7829			
Common Area	C-3	7711	HIDDEN GAZEBO ST	N/S	PRIVATE STREET	
Common Area	D-3	7901	HIDDEN VILLAGE AVE	E/W	PRIVATE STREET	
Common Area	E-3	7901	EVENING SHADOWS AVE	E/W	PRIVATE STREET	
	J-3	7802				

ORIGINAL DATE: 6/06/2002

CITY OF LAS VEGAS
PLANNING & DEVELOPMENT DEPARTMENT

Adrienne M. Low 6/17/02

ADRIENNE LOW, PLANNER I

LAMPLIGHT VILLAGE AT CENTENNIAL SPRINGS UNIT 3

Recorded in Book 105 Page 8 of Plats

200 Scale Map Location: G-16-4

Fire Dept. District Map # 1417:36, 37

MASTER SITE ADDRESS: 7803 PALM GROVE LN

BLOCK 1	LOT	38	7914	EVENING SHADOWS	AVE	E/W	PRIVATE STREET
		39	7910				
		40	7906				
		41	7902				
		42	7848				
		43	7844				
		44	7840				
		45	7836				
	*	46	7832				
		47	7828				
		48	7824				
		49	7820				
		50	7816				
		51	7812				
		52	7808				
		53	7804				
		54	7800				
BLOCK 1	LOT	*55	7736	NATURES SONG ST		N/S	PRIVATE STREET
		56	7732				
		57	7728				
		58	7724				
		59	7720				
		60	7716				
		61	7712				
BLOCK 2	LOT	122	7915	EVENING SHADOWS	AVE	E/W	PRIVATE STREET
		123	7911				
		124	7907				
		125	7903				
		126	7845				
		127	7841				
		128	7837				
		129	7833				
		130	7829				
BLOCK 3	LOT	172	7821	EVENING SHADOWS	AVE	E/W	PRIVATE STREET
		173	7817				
		174	7813				
BLOCK 3	LOT	175	7729	NATURES SONG ST		N/S	PRIVATE STREET
		176	7725				
		177	7721				
		178	7717				
		179	7713				
BLOCK 3	LOT	184	7708	HIDDEN GAZEBO ST		N/S	PRIVATE STREET
		185	7712				
		186	7716				

*Re-sub./merger to "Lamplight Village - Unit 5"

LAMPLIGHT VILLAGE AT CENTENNIAL SPRINGS UNIT 3

BLOCK 3	LOT	187	7720	HIDDEN GAZEBO ST	N/S	PRIVATE STREET
		188	7724			
		189	7728			
BLOCK 4	LOT	134	7915	HIDDEN VILLAGE AVE	E/W	PRIVATE STREET
		135	7911			
		136	7907			
		137	7903			
		138	7845			
		139	7841			
		140	7837			
		141	7833			
		142	7829			
Common Area	C-3	7711	HIDDEN GAZEBO ST	N/S	PRIVATE STREET	
Common Area	D-3	7901	HIDDEN VILLAGE AVE	E/W	PRIVATE STREET	
Common Area	E-3	7901	EVENING SHADOWS AVE	E/W	PRIVATE STREET	
	J-3	7802				

ORIGINAL DATE: 6/06/2002

CITY OF LAS VEGAS
PLANNING & DEVELOPMENT DEPARTMENT

Adrienne M. Low 6/17/02

ADRIENNE LOW, PLANNER I

LAMPLIGHT VILLAGE AT CENTENNIAL SPRINGS UNIT 3

Recorded in Book 105 Page 8 of Plats

200 Scale Map Location: G-16-4

Fire Dept. District Map # 1417:36, 37

MASTER SITE ADDRESS: 7803 PALM GROVE LN

BLOCK 1	LOT	38	7914	EVENING SHADOWS	AVE	E/W	PRIVATE STREET
		39	7910				
		40	7906				
		41	7902				
		42	7848				
		43	7844				
		44	7840				
		45	7836				
	*	46	7832				
		47	7828				
		48	7824				
		49	7820				
		50	7816				
		51	7812				
		52	7808				
		53	7804				
		54	7800				
BLOCK 1	LOT	* 55	7736	NATURES SONG ST		N/S	PRIVATE STREET
		56	7732				
		57	7728				
		58	7724				
		59	7720				
		60	7716				
		61	7712				
BLOCK 2	LOT	122	7915	EVENING SHADOWS	AVE	E/W	PRIVATE STREET
		123	7911				
		124	7907				
		125	7903				
		126	7845				
		127	7841				
		128	7837				
		129	7833				
		130	7829				
BLOCK 3	LOT	172	7821	EVENING SHADOWS	AVE	E/W	PRIVATE STREET
		173	7817				
		174	7813				
BLOCK 3	LOT	175	7729	NATURES SONG ST		N/S	PRIVATE STREET
		176	7725				
		177	7721				
		178	7717				
		179	7713				
BLOCK 3	LOT	184	7708	HIDDEN GAZEBO ST		N/S	PRIVATE STREET
		185	7712				
		186	7716				

* Re-Sub./Merger "Lamplight Village - Unit 5"

LAMPLIGHT VILLAGE AT CENTENNIAL SPRINGS UNIT 3

BLOCK 3	LOT	187	7720	HIDDEN GAZEBO ST	N/S	PRIVATE STREET
		188	7724			
		189	7728			
BLOCK 4	LOT	134	7915	HIDDEN VILLAGE AVE	E/W	PRIVATE STREET
		135	7911			
		136	7907			
		137	7903			
		138	7845			
		139	7841			
		140	7837			
		141	7833			
		142	7829			
Common Area	C-3	7711	HIDDEN GAZEBO ST	N/S	PRIVATE STREET	
Common Area	D-3	7901	HIDDEN VILLAGE AVE	E/W	PRIVATE STREET	
Common Area	E-3	7901	EVENING SHADOWS AVE	E/W	PRIVATE STREET	
	J-3	7802				

ORIGINAL DATE: 6/06/2002

CITY OF LAS VEGAS
PLANNING & DEVELOPMENT DEPARTMENT

Adrienne M. Low 6/17/02

ADRIENNE LOW, PLANNER I

LAMPLIGHT VILLAGE AT CENTENNIAL SPRINGS UNIT 3

Recorded in Book 105 Page 8 of Plats

200 Scale Map Location: G-16-4

Fire Dept. District Map # 1417:36, 37

MASTER SITE ADDRESS: 7803 PALM GROVE LN

BLOCK 1	LOT	38	7914	EVENING SHADOWS	AVE	E/W	PRIVATE STREET
		39	7910				
		40	7906				
		41	7902				
		42	7848				
		43	7844				
		44	7840				
	*	45	7836				
		46	7832				
		47	7828				
		48	7824				
		49	7820				
		50	7816				
		51	7812				
		52	7808				
		53	7804				
		54	7800				
		* and					
BLOCK 1	LOT	*55	7736	NATURES SONG ST		N/S	PRIVATE STREET
		56	7732				
		57	7728				
		58	7724				
		59	7720				
		60	7716				
		61	7712				
BLOCK 2	LOT	122	7915	EVENING SHADOWS	AVE	E/W	PRIVATE STREET
		123	7911				
		124	7907				
		125	7903				
		126	7845				
		127	7841				
		128	7837				
		129	7833				
		130	7829				
BLOCK 3	LOT	172	7821	EVENING SHADOWS	AVE	E/W	PRIVATE STREET
		173	7817				
		174	7813				
BLOCK 3	LOT	175	7729	NATURES SONG ST		N/S	PRIVATE STREET
		176	7725				
		177	7721				
		178	7717				
		179	7713				
BLOCK 3	LOT	184	7708	HIDDEN GAZEBO ST		N/S	PRIVATE STREET
		185	7712				
		186	7716				

* Lots no longer exist part of merger / re-subdivision
"Lamplight Village-Unit 5"

LAMPLIGHT VILLAGE AT CENTENNIAL SPRINGS UNIT 3

BLOCK 3	LOT	187	7720	HIDDEN GAZEBO ST	N/S	PRIVATE STREET
		188	7724			
		189	7728			
BLOCK 4	LOT	134	7915	HIDDEN VILLAGE AVE	E/W	PRIVATE STREET
		135	7911			
		136	7907			
		137	7903			
		138	7845			
		139	7841			
		140	7837			
		141	7833			
		142	7829			
Common Area	C-3	7711	HIDDEN GAZEBO ST	N/S	PRIVATE STREET	
Common Area	D-3	7901	HIDDEN VILLAGE AVE	E/W	PRIVATE STREET	
Common Area	E-3	7901	EVENING SHADOWS AVE	E/W	PRIVATE STREET	
	J-3	7802				

ORIGINAL DATE: 6/06/2002


CITY OF LAS VEGAS
PLANNING & DEVELOPMENT DEPARTMENT

Adrienne M. Low 6/17/02

ADRIENNE LOW, PLANNER I

LAMPLIGHT VILLAGE AT CENTENNIAL SPRINGS UNIT 3

THE PLAT OF
A COMMON INTEREST COMMUNITY
SITUATE IN THE CITY OF LAS VEGAS, CLARK COUNTY, NEVADA BEING A PORTION OF THE SOUTHWEST ONE-QUARTER OF THE NORTHEAST ONE-QUARTER OF SECTION 16,
TOWNSHIP 19 SOUTH, RANGE 60 EAST, M.D.M.

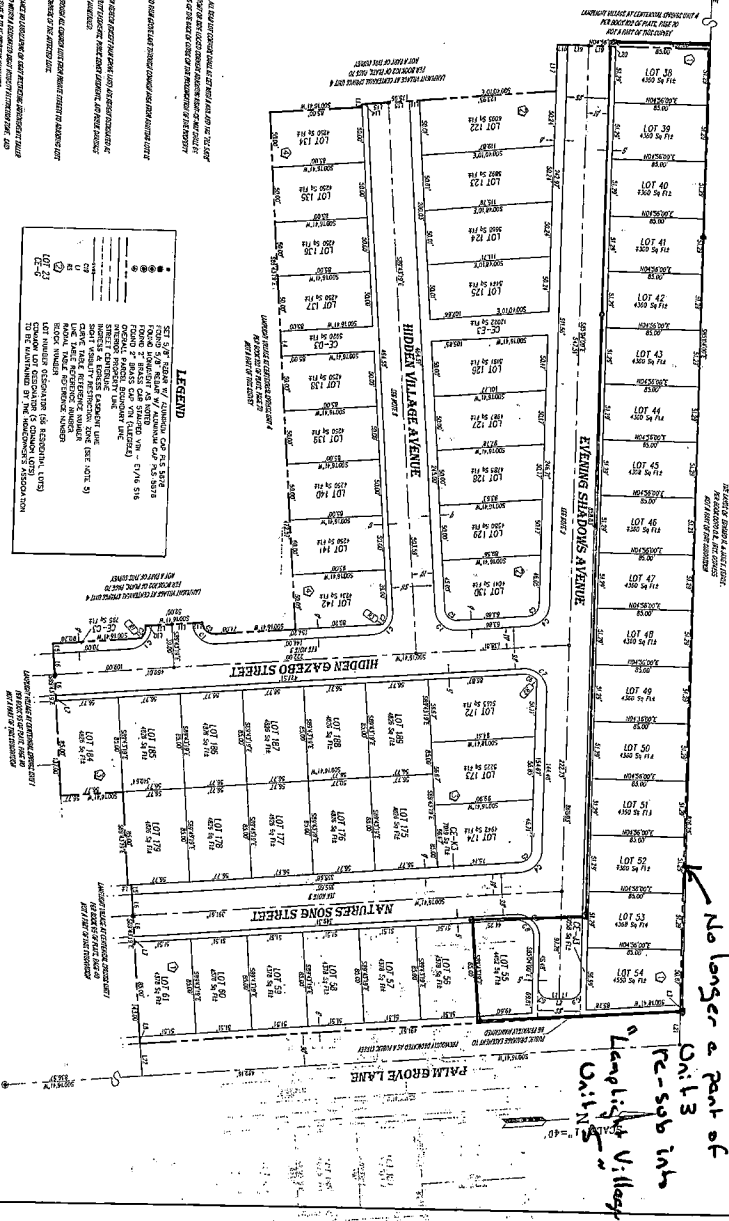

LEGEND

1	2	
---	---	---	---	---	---	---	---	---	----	----	-----

FILE COPY