

IRONWOOD CONDOMINIUMS AMENDED

Recorded in Book 80 Page 98 of Plats

200 Scale Map Location: L-28-7

Fire Dept. District Map # 2317:92

MASTER SITE ADDRESS: 8354 WESTCLIFF DR

BLDG	4	UNIT	421 422 431 432	108	LEMON GLAZE ST	202 203 201 204	N/S	PRIVATE STREET
BLDG	5	UNIT	521 522 531 532	8300	CHERRY GLAZE AVE	204 201 203 202	EW	PRIVATE STREET
BLDG	6	UNIT	621 622 631 632	8305	CHERRY GLAZE AVE	202 203 201 204	EW	PRIVATE STREET
BLDG	7	UNIT	721 722 731 732	8309	CHERRY GLAZE AVE	202 203 201 204	EW	PRIVATE STREET
BLDG	8	UNIT	821 822 831 832	120	EMERALD FOREST ST	202 203 201 204	N/S	PRIVATE STREET
BLDG	9	UNIT	921 922 931 932	112	EMERALD FOREST ST	202 203 201 204	N/S	PRIVATE STREET
BLDG	12	UNIT	1221 1222 1231 1232	121	EMERALD FOREST ST	204 201 203 202	N/S	PRIVATE STREET
BLDG	13	UNIT	1321 1322 1331 1332	117	EMERALD FOREST ST	204 201 203 202	N/S	PRIVATE STREET
BLDG	14	UNIT	1421 1422 1431 1432	113	EMERALD FOREST ST	202 203 201 204	N/S	PRIVATE STREET
BLDG	15	UNIT	1521 1522 1531 1532	109	BREEZY TREE CT	204 201 203 202	N/S	PRIVATE STREET


IRONWOOD CONDOMINIUMS AMENDED

BLDG	16	UNIT	1621 1622 1631 1632	101	BREEZY TREE CT	202 203 201 204	N/S	PRIVATE STREET
BLDG	17	UNIT	1721 1722 1731 1732	100	BREEZY TREE CT	202 203 201 204	N/S	PRIVATE STREET
BLDG	18	UNIT	1821 1822 1831 1832	104	BREEZY TREE CT	204 201 203 202	N/S	PRIVATE STREET
BLDG	19	UNIT	1921 1922 1931 1932	108	BREEZY TREE CT	204 201 203 202	N/S	PRIVATE STREET

ORIGINAL DATE: 2/23/1996

AMENDED DATE: 8/12/1997

CITY OF LAS VEGAS
PLANNING & DEVELOPMENT DEPARTMENT

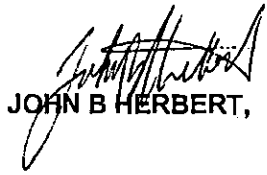

JOHN B HERBERT, PLANNER I

IRONWOOD CONDOMINIUMS AMENDED

Recorded in Book 80 Page 98 of Plats

200 Scale Map Location: L-28-7

Fire Dept. District Map # 2317:92

MASTER SITE ADDRESS: 8354 WESTCLIFF DR

BLDG	4	UNIT	421 422 431 432	108	LEMON GLAZE ST	202 203 201 204	N/S	PRIVATE STREET
BLDG	5	UNIT	521 522 531 532	8300	CHERRY GLAZE AVE	204 201 203 202	E/W	PRIVATE STREET
BLDG	6	UNIT	621 622 631 632	8305	CHERRY GLAZE AVE	202 203 201 204	E/W	PRIVATE STREET
BLDG	7	UNIT	721 722 731 732	8309	CHERRY GLAZE AVE	202 203 201 204	E/W	PRIVATE STREET
BLDG	8	UNIT	821 822 831 832	120	EMERALD FOREST ST	202 203 201 204	N/S	PRIVATE STREET
BLDG	9	UNIT	921 922 931 932	112	EMERALD FOREST ST	202 203 201 204	N/S	PRIVATE STREET
BLDG	12	UNIT	1221 1222 1231 1232	121	EMERALD FOREST ST	204 201 203 202	N/S	PRIVATE STREET
BLDG	13	UNIT	1321 1322 1331 1332	117	EMERALD FOREST ST	204 201 203 202	N/S	PRIVATE STREET
BLDG	14	UNIT	1421 1422 1431 1432	113	EMERALD FOREST ST	202 203 201 204	N/S	PRIVATE STREET
BLDG	15	UNIT	1521 1522 1531 1532	109	BREEZY TREE CT	204 201 203 202	N/S	PRIVATE STREET

IRONWOOD CONDOMINIUMS AMENDED

BLDG	16	UNIT	1621 1622 1631 1632	101	BREEZY TREE CT	202 203 201 204	N/S	PRIVATE STREET
BLDG	17	UNIT	1721 1722 1731 1732	100	BREEZY TREE CT	202 203 201 204	N/S	PRIVATE STREET
BLDG	18	UNIT	1821 1822 1831 1832	104	BREEZY TREE CT	204 201 203 202	N/S	PRIVATE STREET
BLDG	19	UNIT	1921 1922 1931 1932	108	BREEZY TREE CT	204 201 203 202	N/S	PRIVATE STREET

ORIGINAL DATE: 2/23/1996

AMENDED DATE: 8/12/1997

**CITY OF LAS VEGAS
PLANNING & DEVELOPMENT DEPARTMENT**



JOHN B HERBERT, PLANNER I

IRONWOOD CONDOMINIUMS AMENDED

Recorded in Book 80 Page 98 of Plats

200 Scale Map Location: L-28-7

Fire Dept. District Map # 2317:92

MASTER SITE ADDRESS: 8354 WESTCLIFF DR

BLDG	4	UNIT	421 422 431 432	108	LEMON GLAZE ST	202 203 201 204	N/S	PRIVATE STREET
BLDG	5	UNIT	521 522 531 532	8300	CHERRY GLAZE AVE	204 201 203 202	E/W	PRIVATE STREET
BLDG	6	UNIT	621 622 631 632	8305	CHERRY GLAZE AVE	202 203 201 204	E/W	PRIVATE STREET
BLDG	7	UNIT	721 722 731 732	8309	CHERRY GLAZE AVE	202 203 201 204	E/W	PRIVATE STREET
BLDG	8	UNIT	821 822 831 832	120	EMERALD FOREST ST	202 203 201 204	N/S	PRIVATE STREET
BLDG	9	UNIT	921 922 931 932	112	EMERALD FOREST ST	202 203 201 204	N/S	PRIVATE STREET
BLDG	12	UNIT	1221 1222 1231 1232	121	EMERALD FOREST ST	204 201 203 202	N/S	PRIVATE STREET
BLDG	13	UNIT	1321 1322 1331 1332	117	EMERALD FOREST ST	204 201 203 202	N/S	PRIVATE STREET
BLDG	14	UNIT	1421 1422 1431 1432	113	EMERALD FOREST ST	202 203 201 204	N/S	PRIVATE STREET
BLDG	15	UNIT	1521 1522 1531 1532	109	BREEZY TREE CT	204 201 203 202	N/S	PRIVATE STREET


IRONWOOD CONDOMINIUMS AMENDED

BLDG	16	UNIT	1621 1622 1631 1632	101	BREEZY TREE CT	202 203 201 204	N/S	PRIVATE STREET
BLDG	17	UNIT	1721 1722 1731 1732	100	BREEZY TREE CT	202 203 201 204	N/S	PRIVATE STREET
BLDG	18	UNIT	1821 1822 1831 1832	104	BREEZY TREE CT	204 201 203 202	N/S	PRIVATE STREET
BLDG	19	UNIT	1921 1922 1931 1932	108	BREEZY TREE CT	204 201 203 202	N/S	PRIVATE STREET

ORIGINAL DATE: 2/23/1996

AMENDED DATE: 8/12/1997

CITY OF LAS VEGAS
PLANNING & DEVELOPMENT DEPARTMENT

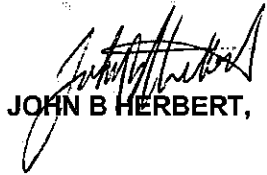

JOHN B HERBERT, PLANNER I

LARRY R. NELSON, P.E.
President

CERTIFICATE OF AMENDMENT

November 3, 1997

Ms. Rita M. Lumos
City Surveyor
City of Las Vegas
400 East Stewart Avenue
Las Vegas, Nevada 89101

DOCUMENT: Amended Ironwood Condominiums A Condominium Community,
Book 80, Page 98 of Plats.

LOCATION: Situate in the City of Las Vegas, County of Clark, Nevada.
Being a portion of the Southwest Quarter (SW 1/4) of the
Southwest Quarter (SW 1/4) Section 28, Township 20 South,
Range 60 East, M.D.M., City of Las Vegas, Clark County,
Nevada.

- STRUCTURAL
- CIVIL
- SURVEY

RECORDING DATE: August 12, 1997

In accordance with the provisions of N.R.S. 278.473, I, Brent Ross Woolsey, a Professional Land Surveyor, hereby request that this Document Amend the **Legal Description and Legend** of the Amended final map of Ironwood Condominiums A Condominium Community recorded August 12, 1997, in Book 80 Page 98 of Plats, Clark County, Nevada Records. The units in buildings 1, 2, 3, 10, and 11, and all of the units of the other buildings on the ground floor should not have been included in the legal description; and the Legend does not indicate the numbers for the ground units and the upstairs units. The legal description will be changed and the Legend will be added to as follows:

LEGAL DESCRIPTION

A PORTION OF THE SOUTHEAST QUARTER (SE1/4) OF THE SOUTHWEST QUARTER (SW1/4) OF THE SOUTHWEST QUARTER (SW1/4) OF SECTION 28, TOWNSHIP 20, SOUTH, RANGE 60 EAST, M. D. M., CLARK COUNTY, NEVADA DESCRIBED AS FOLLOWS:

UNITS 421, 422, 431 AND 432 IN BUILDING 4; UNITS 521, 522, 531 AND 532 IN BUILDING 5; UNITS 621, 622, 631 AND 632 IN BUILDING 6; UNITS 721, 722, 731 AND 732 IN BUILDING 7; UNITS 821, 822, 831 AND 832 IN BUILDING 8; UNITS 921, 922, 931 AND 932 IN BUILDING 9; UNITS 1221, 1222, 1231 AND 1232 IN BUILDING 12; UNITS 1321, 1322, 1331 AND 1332 IN BUILDING 13; UNITS 1421, 1422, 1431 AND 1432 IN BUILDING 14; UNITS 1521, 1522, 1531 AND 1532 IN BUILDING 15; UNITS 1621, 1622, 1631 AND 1632 IN BUILDING 16; UNITS 1721, 1722, 1731 AND 1732 IN BUILDING 17; UNITS 1821, 1822, 1831 AND 1832 IN BUILDING 18; UNITS 1921, 1922, 1931 AND 1932 IN BUILDING 19; OF IRONWOOD CONDOMINIUMS, AS SHOWN BY MAP THEREOF ON FILE IN BOOK 72, PAGE 27, IN THE OFFICE OF THE COUNTY RECORDER OF CLARK COUNTY, NEVADA.

3035 East Patrick Lane
Suite 9
Las Vegas, NV 89120

Phone
702 / 798-7978


FAX
702 / 451-2296

Ironwood Condominiums
Book 80 Page 98
November 3, 1997
Page 2 of 2 Pages

LEGEND

Unit Numbering Unit No's ending with 11 or 12 are ground floor.
Unit No's ending with 21,22,31 or 32 are upstairs.

Brent Ross Woolsey
Professional Land Surveyor
Nevada Certificate No. 4301

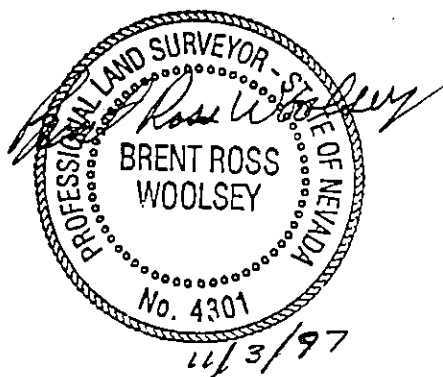

I hereby certify that I have examined the Certificate of Amendment and that the changes to the original document specified therein are provided for in applicable sections of N.R.S. 278.010 to 278.630, inclusive, 625.340 to 625.380, inclusive, and local ordinances adopted pursuant thereto, and I am satisfied that this Certificate of Amendment so amends or corrects the document to make it technically correct.

Rita M. Lumos
Rita M. Lumos, P.L.S. 11/3/97
City Surveyor, City of Las Vegas
Nevada Certificate No. 5094

When Recorded mail to:
L. R. Nelson Consulting Engineers, Inc.
3035 East Patrick Lane
Las Vegas, NV 89120

CLARK COUNTY, NEVADA
JUDITH A. VANDEVER, RECORDER
RECORDED AT REQUEST OF:
LR NELSON CONSULTING ENGINEERS I

11-04-97 13:29 BJB 2
BOOK: 971104 INST: 00983

FEE: 8.00 RPTT: .00
CA PLAT

CONFORMED COPY-HAS NOT BEEN COMPARED TO THE ORIGINAL