

# IRON MOUNTAIN RANCH - VILLAGE 7 - UNIT 2

Recorded in Book 105 Page 24 of Plats

200 Scale Map Location: G-12-4

Fire Dept. District Map # 1321:38

MASTER SITE ADDRESS: 8502 BIGHORN RIVER ST

BLOCK A	LOT	794	4912	WHISTLING ACRES AVE	E/W	PUBLIC STREET
		795	4916			
		796	4920			
		797	4924			
		798	4928			
		799	5000			
		800	5004			
		801	5008			
		802	5012			
		803	5016			
		804	5020			
		805	5024			
		806	5028			
		807	5032			
		808	5036			
		809	5040			
		810	5044			
		811	5048			
		812	5052			
		813	5056			
		814	5060			
		815	5064			
		816	5068			
BLOCK A	LOT	817	8559	WARTHEN MEADOWS ST	N/S	PUBLIC STREET
		818	8555			
		819	8551			
		820	8547			
		821	8543			
		822	8539			
		823	8535			
		824	8531			
		825	8527			
		826	8523			
		827	8519			
		828	8515			
BLOCK E	LOT	966	8500	BIGHORN RIVER ST	N/S	PUBLIC STREET
		967	8504			
		968	8508			
		969	8512			
		970	8516			
		971	8520			
		972	8524			
		973	8528			
		974	8532			
BLOCK F	LOT	917	5061	DIAMOND RANCH AVE	E/W	PUBLIC STREET
		918	5057			

## IRON MOUNTAIN RANCH - VILLAGE 7 - UNIT 2

BLOCK F	LOT	919	5053	DIAMOND RANCH AVE	E/W	PUBLIC STREET
		920	5049			
		921	5045			
		922	5041			
		923	5037			
		924	5033			
		925	5029			
		926	5025			
		927	5021			
		928	5017			
		929	5013			
		930	5009			
		931	5005			
		932	5001			
BLOCK G	LOT	933	5000	DIAMOND RANCH AVE	E/W	PUBLIC STREET
		934	5004			
		935	5008			
		936	5012			
		937	5016			
		938	5020			
		939	5024			
		940	5028			
		941	5032			
		942	5036			
		943	5040			
		944	5044			
		945	5048			
		946	5052			
BLOCK G	LOT	947	8532	WARTHEN MEADOWS ST	N/S	PUBLIC STREET
		948	8536			
		949	8540			
		950	8544			
		951	8548			
BLOCK G	LOT	952	5053	WHISTLING ACRES AVE	E/W	PUBLIC STREET
		953	5049			
		954	5045			
		955	5041			
		956	5037			
		957	5033			
		958	5029			
		959	5025			
		960	5021			
		961	5017			
		962	5013			
		963	5009			
		964	5005			
		965	5001			
Common Area		2A	5045	BRENT LN	E/W	PUBLIC STREET

No addresses on HORSESHOE HILLS AVENUE or THOM BOULEVARD (N/S Public Streets).

ORIGINAL DATE: 6/17/2002

**CITY OF LAS VEGAS  
PLANNING & DEVELOPMENT DEPARTMENT**

*Adrienne M. Low*

**ADRIENNE LOW, PLANNER I**

70- L-4718-02 APR 5 2005 22-1

# I.M. R-Village 7 - Proposed Sales & Leases

USA#458999

ZONING: R-E WITH R.O.I. TO C-V  
LAND USE: VACANT  
(FUTURE HIGH SCHOOL)

POWER POLE (TEMP)

Clear: 11/6 @ 9:30

Exp: 11/18

## 5054 DIAMOND RANCH

LOT 948  
BLK F


05 NOV 2002

R-E  
OR-PD  
VACANT

R-E  
VACANT

R-E  
R-PD2  
VACANT

R-E  
R-PD1  
SINGLE  
ENTIA

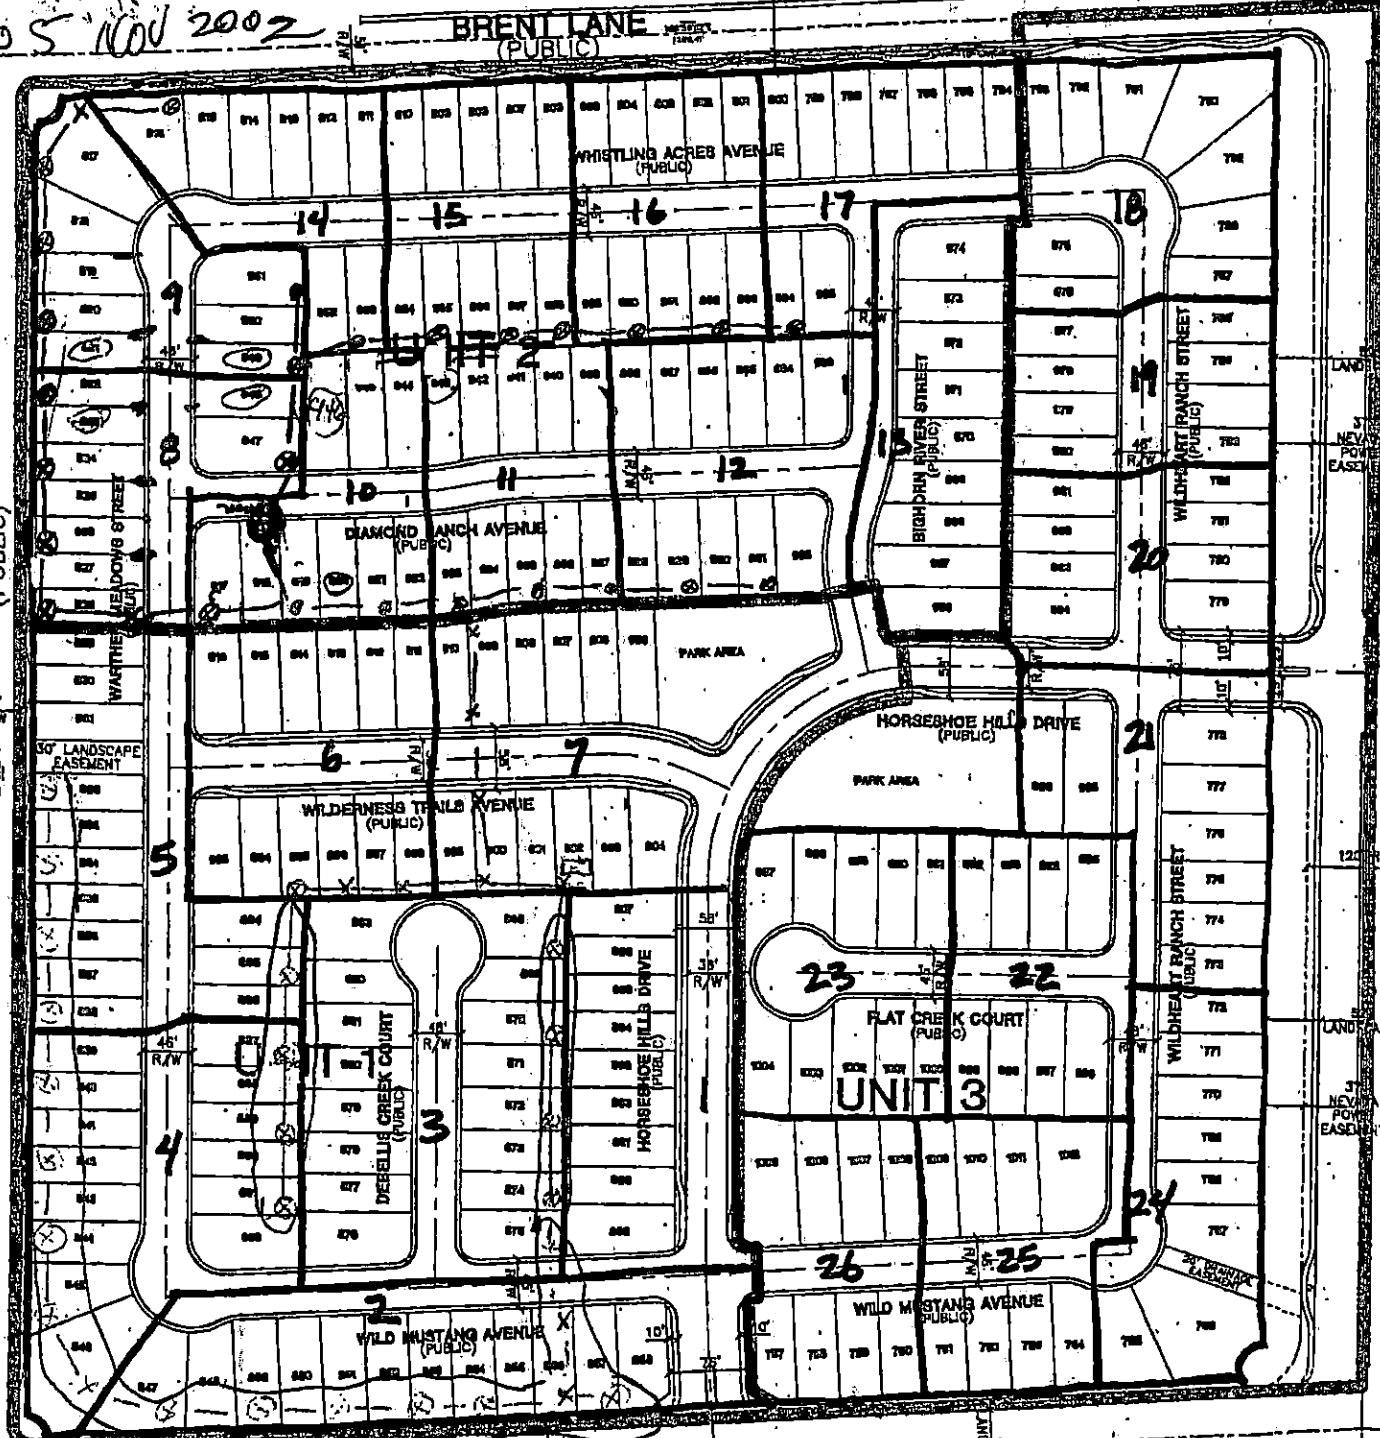

ZONING: R-E  
WITH R.O.I. TO R-PD5  
LAND USE: VACANT



