

IRON MOUNTAIN ESTATES WEST UNIT 1

Recorded in Book 106 Page 99 of Plats

200 Scale Map Location: G-5-7

Fire Dept. District Map # 1216:82; 92

MASTER SITE ADDRESS: 9030 O'HARE RD

BLOCK 5	LOT	243	9021	BARIUM ROCK AVE	E/W	PRIVATE STREET
		244	9029			
		245	9037			
		246	9045			
		247	9053			
		248	9061			
		249	9062			
		250	9054			
		251	9046			
		252	9038			
BLOCK 5	LOT	253	9037	PATINAGEM AVE	E/W	PRIVATE STREET
		254	9045			
		255	9053			
		256	9061			
BLOCK 5	LOT	257	9405	LEADBRICK ST	N/S	PRIVATE STREET
BLOCK 6	LOT	258	9411	LEADBRICK ST	N/S	PRIVATE STREET
		259	9417			
		260	9423			
		261	9505			
		262	9511			
		263	9517			
		264	9516			
		265	9510			
		266	9504			
		267	9422			
		268	9416			
		269	9410			
BLOCK 6	LOT	270	9028	ZINKMIST CT	E/W	PRIVATE STREET
		271	9020			
		272	9012			
		273	9013			
		274	9029			
BLOCK 6	LOT	275	9028	BARIUM ROCK AVE	E/W	PRIVATE STREET
		276	9020			
Common Area		1A	9035	O'HARE RD	E/W	PUBLIC STREET
Common Area		1B	9034	IRON MOUNTAIN RD	E/W	PUBLIC STREET
Common Area		1C		(ALL PRIVATE DRIVES)		PRIVATE STREET
Common Area		1D	9063	PATINAGEM AVE	E/W	PRIVATE STREET
Common Area		1E	9063	BARIUM ROCK AVE	E/W	PRIVATE STREET

IRON MOUNTAIN ESTATES WEST UNIT 1

Common Area	1F	9010	ZINKMIST CT	E/W	PRIVATE STREET
Common Area	1G	9055	O'HARE RD	E/W	PUBLIC STREET

ORIGINAL DATE: 10/17/2002

**CITY OF LAS VEGAS
PLANNING & DEVELOPMENT DEPARTMENT**



STEPHEN SWANTON, PLANNER I

125-05-403-002
125-05-404-001



CONSULTING ENGINEERS • PLANNERS • SURVEYORS
PROVIDING QUALITY PROFESSIONAL
SERVICES SINCE 1960

February 6, 2003
W.O.#5463-4-1
Page 1 of 2

Rita M. Lumos, P.L.S.
City of Las Vegas Surveyor

CERTIFICATE OF AMENDMENT

Document:

IRON MOUNTAIN ESTATES WEST - UNIT 1; BOOK 106 / PAGE
99 OF PLATS

Legal

Description:

(A COMMON INTEREST COMMUNITY) BEING A PORTION OF
THE SOUTH HALF (S 1/2) OF THE SOUTHWEST QUARTER (SW
1/4) OF SECTION 5, TOWNSHIP 19 SOUTH, RANGE 60 EAST,
M.D.M., CITY OF LAS VEGAS, CLARK COUNTY, NEVADA.

Recording

Date:

10/17/02

Caption


The purpose of this Certificate of Amendment is to correct the street
suffix of a street name:
"O' Hare Avenue" is hereby amended to read as "O'Hare Road" as
shown in the legal description on sheet one and the street outlines as
shown on sheet 2 and as shown on detail "A", detail "B" and the survey
analysis map on sheet 4.

This document supersedes the original recorded document.

I do hereby declare that this correction does not change the physical location of any
survey monument, property line, or boundary line.

Respectfully,

Anthony Zicari, P.L.S.
Nevada License No. 11449

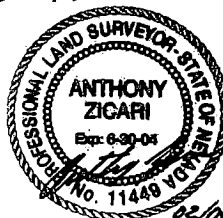

February 6, 2003

W.O. #5463-4-1

Page 2 of 2

City of Las Vegas Surveyor's Certificate

I hereby certify that I have examined the Certificate of Amendment and that the changes to the original document specified therein are provided for in the applicable sections of N.R.S. 278.010 to 278.630 inclusive, N.R.S. 625.340 to 625.380 inclusive, and local ordinances adopted pursuant thereto, and I am satisfied that this Certificate of Amendment so amends or corrects the document as to make it technically correct.

Rita M. Lumos
Rita M. Lumos 2/10/03
City of Las Vegas Surveyor
P.L.S. #5094

WHEN RECORDED, MAIL TO:


**VTN NEVADA
2727 S. RAINBOW BLVD
LAS VEGAS, NV. 89102**

CLARK COUNTY, NEVADA
FRANCES DEANE RECORDERS
RECORDED AT REQUEST OF: VTN NEVADA

02-13-2003 16:18 STX PAGE COUNT: 2
BOOK/INSTR: 20030213-02340 FEE: 15.00
PLAT/CA RPTT: .00

RECEIPT/CONF COPY-HAS NOT BEEN COMPARED TO THE ORIG

PATINAGEM AVENUE

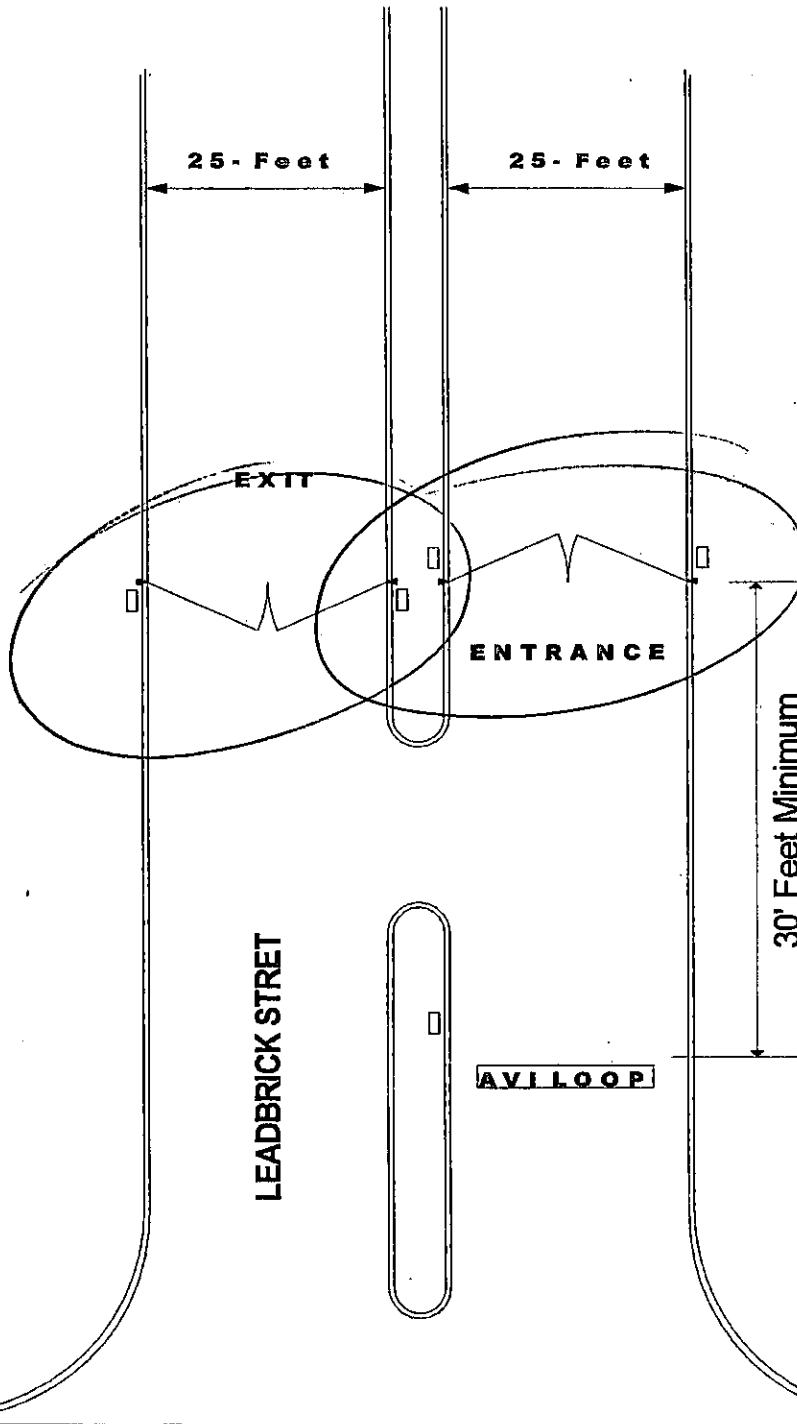

ENT. GATES:
USING MSA- 2030 O'HARE AD.
2002. M. 20 AF

O'HARE AVENUE

FIRE DEPT. ACCESS DRAWING
ASTORIA HOMES
IRON MOUNTAIN ESTATES - WEST UNIT 1
11/15/02
11/15/02

