

LANGLEY ESTATES AMENDED PORTION

Recorded in Book 84 Page 78 of Plats

200 Scale Map Location: Q-4-6

Fire Dept. District Map # 2517:69


MASTER SITE ADDRESS: 1921 LANGLEY ESTATES ST

BLOCK 1 LOT 1 1921 LANGLEY ESTATES ST N/S PRIVATE STREET

ORIGINAL DATE: 1/05/1998

AMENDED DATE: 6/12/1998

CITY OF LAS VEGAS
PLANNING & DEVELOPMENT DEPARTMENT

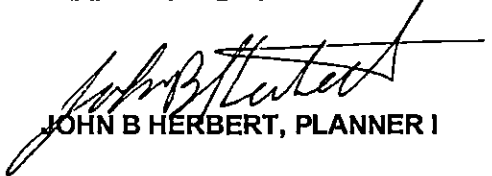


JOHN B HERBERT, PLANNER I

LANGLEY ESTATES


BEING A PORTION OF THE EAST HALF (E 1/2) OF GOVERNMENT LOT THIRTY-EIGHT (38), IN THE NORTHEAST QUARTER (NE 1/4) OF THE SOUTHEAST QUARTER (SE 1/4) OF SECTION 4, TOWNSHIP 21 SOUTH, RANGE 80 EAST, M.D.M., CITY OF LAS VEGAS, COUNTY OF CLARK, STATE OF NEVADA. . .

CURVE TABLE				

NOTES:
ALL REAR LOT CORNERS SHALL BE SET WITH A NAIL AND BRASS TAG PLAS 8002 ON THE BLOCK WALL AND ALL FRONT OR SIDE CORNERS ADJOINING PUBLIC RIGHTS-OF-WAY AND PRIVATE STREETS SHALL BE MARKED BY THE SMOOTHING OF THE BROAD SIDEWALK.

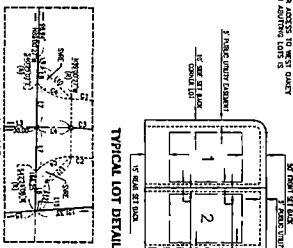


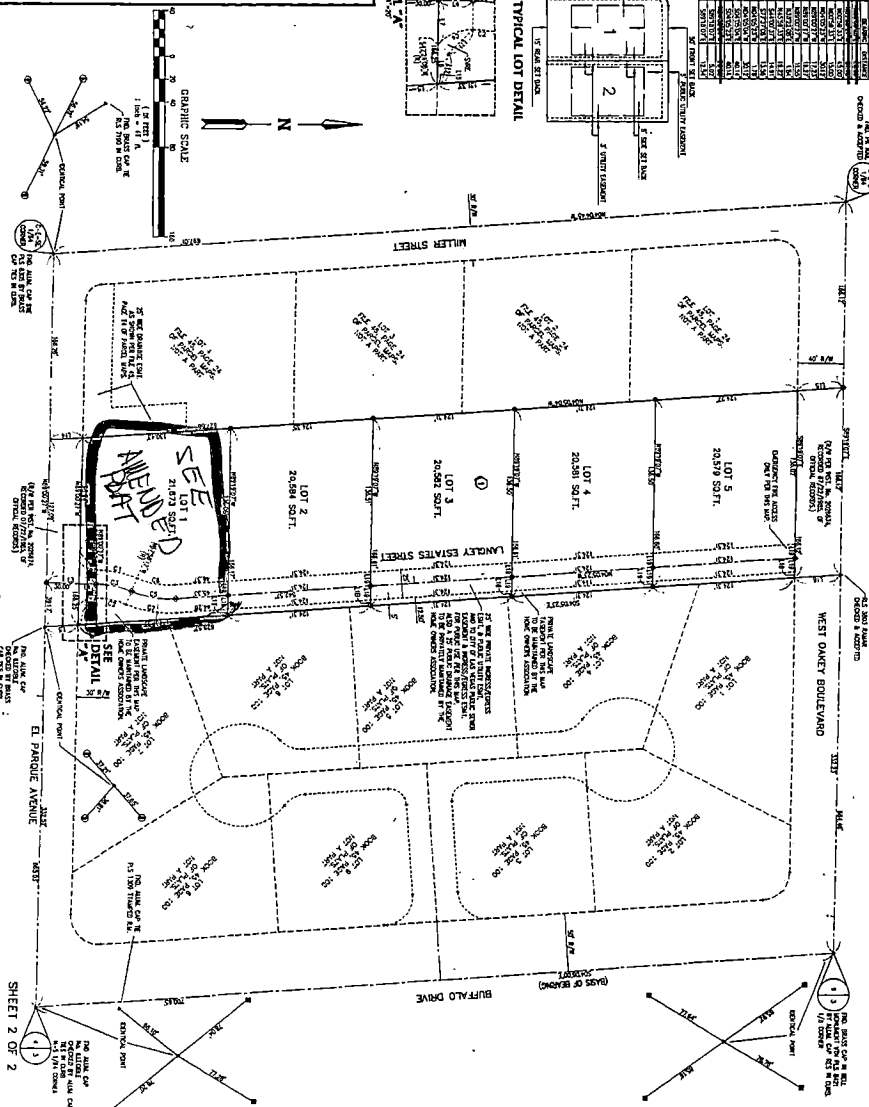

LANGLEY ESTATES

Recorded in Book 82 Page 80 of Plats

200 Scale Map Location: Q-4-6

Fire Dept. District Map # 2517:59, 69

MASTER SITE ADDRESS: 7810 W. EL PARQUE AVE


BLOCK 1	LOT	2	1911	LANGLEY ESTATES ST	N/S	PRIVATE STREET
		3	1901			
		4	1811			
		5	1801			

SEE THE AMENDED FINAL MAP of A PORTION of LANGLEY ESTATES for
LOT 1

ORIGINAL DATE: 1/05/1998

AMENDED DATE: 6/12/1998

CITY OF LAS VEGAS
PLANNING & DEVELOPMENT DEPARTMENT

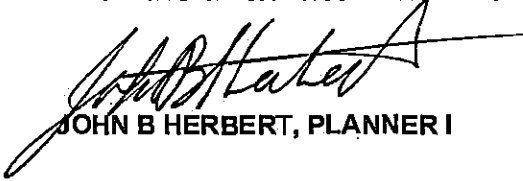

JOHN B HERBERT, PLANNER I

LANGLEY ESTATES

Recorded in Book 82 Page 80 of Plats

200 Scale Map Location: Q-4-6

Fire Dept. District Map # 2517:59, 69

MASTER SITE ADDRESS: 7810 W. EL PARQUE AVE


BLOCK 1	LOT	2	1911	LANGLEY ESTATES ST	N/S	PRIVATE STREET
		3	1901			
		4	1811			
		5	1801			

SEE THE AMENDED FINAL MAP of A PORTION of LANGLEY ESTATES for
LOT 1

ORIGINAL DATE: 1/05/1998

AMENDED DATE: 6/12/1998

CITY OF LAS VEGAS
PLANNING & DEVELOPMENT DEPARTMENT

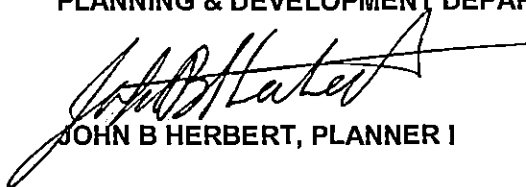

JOHN B HERBERT, PLANNER I

LANGLEY ESTATES

Recorded in Book 82 Page 80 of Plats

200 Scale Map Location: Q-4-6

Fire Dept. District Map # 2517:59, 69

MASTER SITE ADDRESS: 7810 W. EL PARQUE AVE


BLOCK 1	LOT	2	1911	LANGLEY ESTATES ST	N/S	PRIVATE STREET
		3	1901			
		4	1811			
		5	1801			

SEE THE AMENDED FINAL MAP of A PORTION of LANGLEY ESTATES for
LOT 1

ORIGINAL DATE: 1/05/1998

AMENDED DATE: 6/12/1998

CITY OF LAS VEGAS
PLANNING & DEVELOPMENT DEPARTMENT

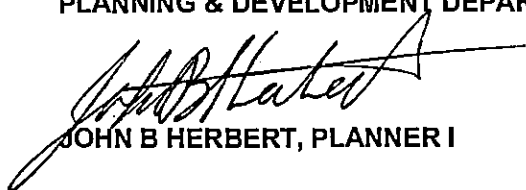

JOHN B HERBERT, PLANNER I

LANGLEY ESTATES

Recorded in Book 82 Page 80 of Plats

200 Scale Map Location: Q-4-6

Fire Dept. District Map # 2517:59, 69

MASTER SITE ADDRESS: 7810 W. EL PARQUE AVE


BLOCK 1	LOT	2	1911	LANGLEY ESTATES ST	N/S	PRIVATE STREET
		3	1901			
		4	1811			
		5	1801			

SEE THE AMENDED FINAL MAP of A PORTION of LANGLEY ESTATES for
LOT 1

ORIGINAL DATE: 1/05/1998

AMENDED DATE: 6/12/1998

CITY OF LAS VEGAS
PLANNING & DEVELOPMENT DEPARTMENT

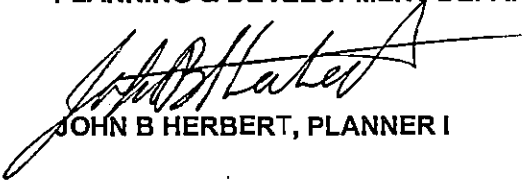

JOHN B HERBERT, PLANNER I

7802 W. EL PARQUE ST - ACCESS GATES ?