

LANGLEY ESTATES AMENDED PORTION

Recorded in Book 84 Page 78 of Plats

200 Scale Map Location: Q-4-6

Fire Dept. District Map # 2517:69


MASTER SITE ADDRESS: 1921 LANGLEY ESTATES ST

BLOCK 1 LOT 1 1921 LANGLEY ESTATES ST N/S PRIVATE STREET

ORIGINAL DATE: 1/05/1998

AMENDED DATE: 6/12/1998

CITY OF LAS VEGAS
PLANNING & DEVELOPMENT DEPARTMENT

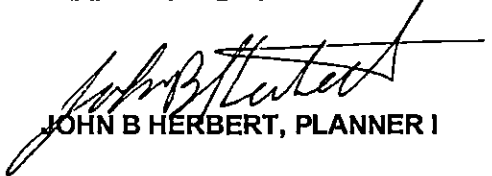

JOHN B HERBERT, PLANNER I

LANGLEY ESTATES

BEING A PORTION OF THE EAST HALF (E 1/2) OF GOVERNMENT LOT THIRTY-EIGHT (38) IN THE NORTHEAST QUARTER (NE 1/4) OF THE SOUTHEAST QUARTER (SE 1/4) OF SECTION 4, TOWNSHIP 21 SOUTH, RANGE 60 EAST, M.D.M., CITY OF LAS VEGAS, COUNTY OF CLARK, STATE OF NEVADA

CURVE TABLE



LINE TABLE


NOTES:



1. ALL LOTS AND BLOCKS SHALL BE SET BACK 10 FEET FROM THE WEST SIDE OF WEST OAKLEY BOULEVARD AND 10 FEET FROM THE SOUTH SIDE OF MILLER STREET. THE SETBACKS SHALL BE MEASURED FROM THE CENTERLINE OF THE HIGHWAY. 

TYPICAL LOT DETAIL

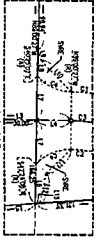


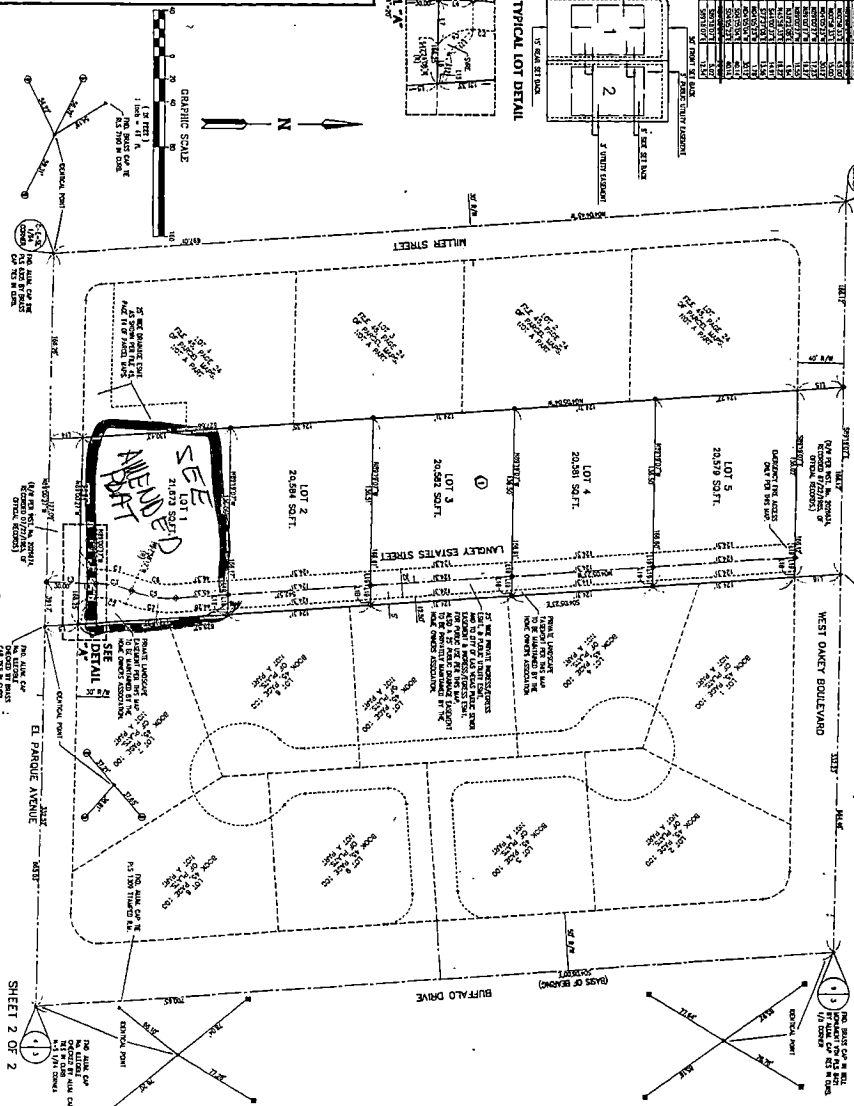 

LANGLEY ESTATES

Recorded in Book 82 Page 80 of Plats

200 Scale Map Location: Q-4-6

Fire Dept. District Map # 2517:59, 69

MASTER SITE ADDRESS: 7810 W. EL PARQUE AVE


BLOCK 1	LOT	2	1911	LANGLEY ESTATES ST	N/S	PRIVATE STREET
		3	1901			
		4	1811			
		5	1801			

SEE THE AMENDED FINAL MAP of A PORTION of LANGLEY ESTATES for
LOT 1

ORIGINAL DATE: 1/05/1998

AMENDED DATE: 6/12/1998

CITY OF LAS VEGAS
PLANNING & DEVELOPMENT DEPARTMENT

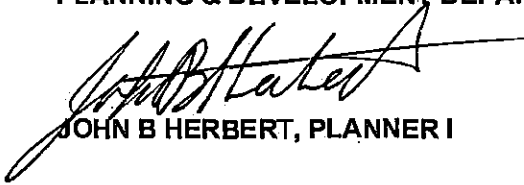

JOHN B HERBERT, PLANNER I

LANGLEY ESTATES

Recorded in Book 82 Page 80 of Plats

200 Scale Map Location: Q-4-6

Fire Dept. District Map # 2517:59, 69

MASTER SITE ADDRESS: 7810 W. EL PARQUE AVE


BLOCK 1	LOT	2	1911	LANGLEY ESTATES ST	N/S	PRIVATE STREET
		3	1901			
		4	1811			
		5	1801			

SEE THE AMENDED FINAL MAP of A PORTION of LANGLEY ESTATES for
LOT 1

ORIGINAL DATE: 1/05/1998

AMENDED DATE: 6/12/1998

CITY OF LAS VEGAS
PLANNING & DEVELOPMENT DEPARTMENT

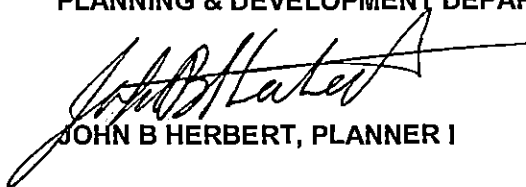

JOHN B HERBERT, PLANNER I

LANGLEY ESTATES

Recorded in Book 82 Page 80 of Plats

200 Scale Map Location: Q-4-6

Fire Dept. District Map # 2517:59, 69

MASTER SITE ADDRESS: 7810 W. EL PARQUE AVE


BLOCK 1	LOT	2	1911	LANGLEY ESTATES ST	N/S	PRIVATE STREET
		3	1901			
		4	1811			
		5	1801			

SEE THE AMENDED FINAL MAP of A PORTION of LANGLEY ESTATES for
LOT 1

ORIGINAL DATE: 1/05/1998

AMENDED DATE: 6/12/1998

CITY OF LAS VEGAS
PLANNING & DEVELOPMENT DEPARTMENT

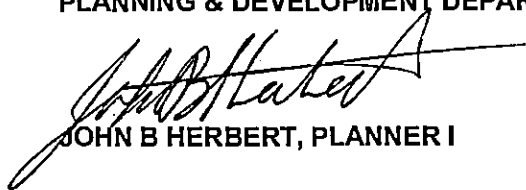

JOHN B HERBERT, PLANNER I

LANGLEY ESTATES

Recorded in Book 82 Page 80 of Plats

200 Scale Map Location: Q-4-6

Fire Dept. District Map # 2517:59, 69

MASTER SITE ADDRESS: 7810 W. EL PARQUE AVE


BLOCK 1	LOT	2	1911	LANGLEY ESTATES ST	N/S	PRIVATE STREET
		3	1901			
		4	1811			
		5	1801			

SEE THE AMENDED FINAL MAP of A PORTION of LANGLEY ESTATES for
LOT 1

ORIGINAL DATE: 1/05/1998

AMENDED DATE: 6/12/1998

CITY OF LAS VEGAS
PLANNING & DEVELOPMENT DEPARTMENT

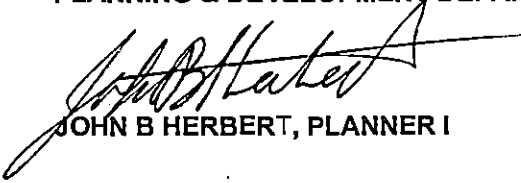

JOHN B HERBERT, PLANNER I

7802 W. EL PARQUE ST - ACCESS GATES ?