

LEWIS HOMES - STONEGATE NO. 3

Street Listing

APRIL 5, 1984

L-34-4

BLOCK	C	LOT					
		1	448	CAPERTINO STREET	N-W	Public Street	
		2	444				
		3	440				
		4	436				
		5	432				
		6	6828	ASHLAND AVENUE	E-W	Public Street	
		7	6824				
		8	6820				
		9	6816				
		10	6812				
		11	6808				
		12	6804				
		13	6800				
		14	6801	MIDPARK CIRCLE	E-W	Public Street	
		15	6805				
		16	6809				
		17	6813				
		18	6817				
		19	6821				
		20	6825				
		21	6829				
		22	6833				
		23	6832				
		24	6828				
		25	6824				
		26	6820				
		27	6816				
		28	6812				
		29	6808				
		30	6804				
		31	6800				
		32	352	WARMSIDE DRIVE	N-S	Public Street	
		33	348				
		34	344				
		35	340				
		36	336				
		37	332				
		38	328				
		39	324				
		40	320				
		41	316				
		42	6801	SPEARFISH AVENUE	E-W	Public Street	
		43	6805				
		44	6809				
		45	6813				
		46	6817				
		47	6821				
		48	309	MANOR STREET	N-S	Public Street	
		49	313				
		50	317				
		51	321				
		52	325				
		53	329				
		54	333				
		55	337				
		56	6821	SWEETWATER PLACE	E-W	Public Street	
		57	6825				
		58	6829				
		59	6833				

LEWIS HOMES - STONEGATE NO. 3
 Street Listing
 April 5, 1984
 Page 2

				L-34-4		
BLOCK	D	LOT				
		60	320	MANOR STREET	N-S	Public Street
		61	316			
		62	312			
		63	308			
		64	304			
		65	300			
		66	6824	SPEARFISH AVENUE	E-W	Public Street
		67	6820			
		68	6816			
		69	6812			
		70	6808			
		71	6804			
		72	6800			
		73	301	WARMSIDE DRIVE	N-S	Public Street
		74	305			
		75	309			
		76	313			
		77	317			
		78	321			
		79	325			
		80	329			
		81	333			
		82	337			
		83	341			
		84	345			
		85	349			
		86	353			
		87	357			
		88	361			
		89	365			
		90	401			
		91	405			
		92	409			
		93	413			
		94	417			
		95	421			
		96	425			
		97	429			
		98	433			
		99	437			
		100	441			
		101	445			
		102	449			
		103	453			
		104	452			
		105	448			
		106	444			
		107	440			
		108	6801	ASHLAND AVENUE	E-W	Public Street
		109	6805			
		110	6809			
		111	6813			
		112	6817			
		113	6821			
		114	437	CAPERTINO STREET	N-W	Public Street
		115	441			
		116	445			
		117	449			

STREETS WITH NO ADDRESSES: Alta Drive, Lorenzi Street, Rainbow Boulevard

JR:dp

 JIM ROBISON
 PLANNING ASSISTANT

LEWIS HOMES - STONEGATE NO. 3

Street Listing

APRIL 5, 1984

L-34-4

BLOCK	C	LOT				
		1	448	CAPERTINO STREET	N-W	Public Street
		2	444			
		3	440			
		4	436			
		5	432			
		6	6828	ASHLAND AVENUE	E-W	Public Street
		7	6824			
		8	6820			
		9	6816			
		10	6812			
		11	6808			
		12	6804			
		13	6800			
		14	6801	MIDPARK CIRCLE	E-W	Public Street
		15	6805			
		16	6809			
		17	6813			
		18	6817			
		19	6821			
		20	6825			
		21	6829			
		22	6833			
		23	6832			
		24	6828			
		25	6824			
		26	6820			
		27	6816			
		28	6812			
		29	6808			
		30	6804			
		31	6800			
		32	352	WARMSIDE DRIVE	N-S	Public Street
		33	348			
		34	344			
		35	340			
		36	336			
		37	332			
		38	328			
		39	324			
		40	320			
		41	316			
		42	6801	SPEARFISH AVENUE	E-W	Public Street
		43	6805			
		44	6809			
		45	6813			
		46	6817			
		47	6821			
		48	309	MANOR STREET	N-S	Public Street
		49	313			
		50	317			
		51	321			
		52	325			
		53	329			
		54	333			
		55	337			
		56	6821	SWEETWATER PLACE	E-W	Public Street
		57	6825			
		58	6829			
		59	6833			

LEWIS HOMES - STONEGATE NO. 3
 Street Listing
 April 5, 1984
 Page 2

L-34-4

BLOCK	D	LOT	ADDRESS	STREET TYPE	STREET NAME
		60	320	N-S	Public Street
		61	316		
		62	312		
		63	308		
		64	304		
		65	300		
		66	6824	E-W	Public Street
		67	6820		
		68	6816		
		69	6812		
		70	6808		
		71	6804		
		72	6800		
		73	301	N-S	Public Street
		74	305		
		75	309		
		76	313		
		77	317		
		78	321		
		79	325		
		80	329		
		81	333		
		82	337		
		83	341		
		84	345		
		85	349		
		86	353		
		87	357		
		88	361		
		89	365		
		90	401		
		91	405		
		92	409		
		93	413		
		94	417		
		95	421		
		96	425		
		97	429		
		98	433		
		99	437		
		100	441		
		101	445		
		102	449		
		103	453		
		104	452		
		105	448		
		106	444		
		107	440		
		108	6801	E-W	Public Street
		109	6805		
		110	6809		
		111	6813		
		112	6817		
		113	6821		
		114	437	N-W	Public Street
		115	441		
		116	445		
		117	449		

STREETS WITH NO ADDRESSES: Alta Drive, Lorenzi Street, Rainbow Boulevard

JR:dp



JIM ROBISON
 PLANNING ASSISTANT

LEWIS HOMES - STONEGATE NO. 3

Street Listing

APRIL 5, 1984

L-34-4

BLOCK	C	LOT					
		1	448	CAPERTINO STREET	N-W	Public Street	
		2	444				
		3	440				
		4	436				
		5	432				
		6	6828	ASHLAND AVENUE	E-W	Public Street	
		7	6824				
		8	6820				
		9	6816				
		10	6812				
		11	6808				
		12	6804				
		13	6800				
		14	6801	MIDPARK CIRCLE	E-W	Public Street	
		15	6805				
		16	6809				
		17	6813				
		18	6817				
		19	6821				
		20	6825				
		21	6829				
		22	6833				
		23	6832				
		24	6828				
		25	6824				
		26	6820				
		27	6816				
		28	6812				
		29	6808				
		30	6804				
		31	6800				
		32	352	WARMSIDE DRIVE	N-S	Public Street	
		33	348				
		34	344				
		35	340				
		36	336				
		37	332				
		38	328				
		39	324				
		40	320				
		41	316				
		42	6801	SPEARFISH AVENUE	E-W	Public Street	
		43	6805				
		44	6809				
		45	6813				
		46	6817				
		47	6821				
		48	309	MANOR STREET	N-S	Public Street	
		49	313				
		50	317				
		51	321				
		52	325				
		53	329				
		54	333				
		55	337				
		56	6821	SWEETWATER PLACE	E-W	Public Street	
		57	6825				
		58	6829				
		59	6833				

LEWIS HOMES - STONEGATE NO. 3
 Street Listing
 April 5, 1984
 Page 2

L-34-4

BLOCK	D	LOT				
		60	320	MANOR STREET	N-S	Public Street
		61	316			
		62	312			
		63	308			
		64	304			
		65	300			
		66	6824	SPEARFISH AVENUE	E-W	Public Street
		67	6820			
		68	6816			
		69	6812			
		70	6808			
		71	6804			
		72	6800			
		73	301	WARMSIDE DRIVE	N-S	Public Street
		74	305			
		75	309			
		76	313			
		77	317			
		78	321			
		79	325			
		80	329			
		81	333			
		82	337			
		83	341			
		84	345			
		85	349			
		86	353			
		87	357			
		88	361			
		89	365			
		90	401			
		91	405			
		92	409			
		93	413			
		94	417			
		95	421			
		96	425			
		97	429			
		98	433			
		99	437			
		100	441			
		101	445			
		102	449			
		103	453			
		104	452			
		105	448			
		106	444			
		107	440			
		108	6801	ASHLAND AVENUE	E-W	Public Street
		109	6805			
		110	6809			
		111	6813			
		112	6817			
		113	6821			
		114	437	CAPERTINO STREET	N-W	Public Street
		115	441			
		116	445			
		117	449			

STREETS WITH NO ADDRESSES: Alta Drive, Lorenzi Street, Rainbow Boulevard

JR:dp

 JIM ROBISON
 PLANNING ASSISTANT

LEWIS HOMES - STONEGATE NO. 3

Street Listing

APRIL 5, 1984

L-34-4

BLOCK	C	LOT					
		1	448	CAPERTINO STREET	N-W	Public Street	
		2	444				
		3	440				
		4	436				
		5	432				
		6	6828	ASHLAND AVENUE	E-W	Public Street	
		7	6824				
		8	6820				
		9	6816				
		10	6812				
		11	6808				
		12	6804				
		13	6800				
		14	6801	MIDPARK CIRCLE	E-W	Public Street	
		15	6805				
		16	6809				
		17	6813				
		18	6817				
		19	6821				
		20	6825				
		21	6829				
		22	6833				
		23	6832				
		24	6828				
		25	6824				
		26	6820				
		27	6816				
		28	6812				
		29	6808				
		30	6804				
		31	6800				
		32	352	WARMSIDE DRIVE	N-S	Public Street	
		33	348				
		34	344				
		35	340				
		36	336				
		37	332				
		38	328				
		39	324				
		40	320				
		41	316				
		42	6801	SPEARFISH AVENUE	E-W	Public Street	
		43	6805				
		44	6809				
		45	6813				
		46	6817				
		47	6821				
		48	309	MANOR STREET	N-S	Public Street	
		49	313				
		50	317				
		51	321				
		52	325				
		53	329				
		54	333				
		55	337				
		56	6821	SWEETWATER PLACE	E-W	Public Street	
		57	6825				
		58	6829				
		59	6833				

LEWIS HOMES - STONEGATE NO. 3
 Street Listing
 April 5, 1984
 Page 2

L-34-4

BLOCK	D	LOT	Address	Direction	Street Type
		60	320	MANOR STREET	N-S Public Street
		61	316		
		62	312		
		63	308		
		64	304		
		65	300		
		66	6824	SPEARFISH AVENUE	E-W Public Street
		67	6820		
		68	6816		
		69	6812		
		70	6808		
		71	6804		
		72	6800		
		73	301	WARMSIDE DRIVE	N-S Public Street
		74	305		
		75	309		
		76	313		
		77	317		
		78	321		
		79	325		
		80	329		
		81	333		
		82	337		
		83	341		
		84	345		
		85	349		
		86	353		
		87	357		
		88	361		
		89	365		
		90	401		
		91	405		
		92	409		
		93	413		
		94	417		
		95	421		
		96	425		
		97	429		
		98	433		
		99	437		
		100	441		
		101	445		
		102	449		
		103	453		
		104	452		
		105	448		
		106	444		
		107	440		
		108	6801	ASHLAND AVENUE	E-W Public Street
		109	6805		
		110	6809		
		111	6813		
		112	6817		
		113	6821		
		114	437	CAPERTINO STREET	N-W Public Street
		115	441		
		116	445		
		117	449		

STREETS WITH NO ADDRESSES: Alta Drive, Lorenzi Street, Rainbow Boulevard

JR:dp

 JIM ROBISON
 PLANNING ASSISTANT

LEWIS HOMES - STONEGATE NO. 3

Street Listing

APRIL 5, 1984

L-34-4

BLOCK	C	LOT					
		1	448	CAPERTINO STREET	N-W	Public Street	
		2	444				
		3	440				
		4	436				
		5	432				
		6	6828	ASHLAND AVENUE	E-W	Public Street	
		7	6824				
		8	6820				
		9	6816				
		10	6812				
		11	6808				
		12	6804				
		13	6800				
		14	6801	MIDPARK CIRCLE	E-W	Public Street	
		15	6805				
		16	6809				
		17	6813				
		18	6817				
		19	6821				
		20	6825				
		21	6829				
		22	6833				
		23	6832				
		24	6828				
		25	6824				
		26	6820				
		27	6816				
		28	6812				
		29	6808				
		30	6804				
		31	6800				
		32	352	WARMSIDE DRIVE	N-S	Public Street	
		33	348				
		34	344				
		35	340				
		36	336				
		37	332				
		38	328				
		39	324				
		40	320				
		41	316				
		42	6801	SPEARFISH AVENUE	E-W	Public Street	
		43	6805				
		44	6809				
		45	6813				
		46	6817				
		47	6821				
		48	309	MANOR STREET	N-S	Public Street	
		49	313				
		50	317				
		51	321				
		52	325				
		53	329				
		54	333				
		55	337				
		56	6821	SWEETWATER PLACE	E-W	Public Street	
		57	6825				
		58	6829				
		59	6833				

LEWIS HOMES - STONEGATE NO. 3
 Street Listing
 April 5, 1984
 Page 2

L-34-4						
BLOCK	D	LOT				
		60	320	MANOR STREET	N-S	Public Street
		61	316			
		62	312			
		63	308			
		64	304			
		65	300			
		66	6824	SPEARFISH AVENUE	E-W	Public Street
		67	6820			
		68	6816			
		69	6812			
		70	6808			
		71	6804			
		72	6800			
		73	301	WARMSIDE DRIVE	N-S	Public Street
		74	305			
		75	309			
		76	313			
		77	317			
		78	321			
		79	325			
		80	329			
		81	333			
		82	337			
		83	341			
		84	345			
		85	349			
		86	353			
		87	357			
		88	361			
		89	365			
		90	401			
		91	405			
		92	409			
		93	413			
		94	417			
		95	421			
		96	425			
		97	429			
		98	433			
		99	437			
		100	441			
		101	445			
		102	449			
		103	453			
		104	452			
		105	448			
		106	444			
		107	440			
		108	6801	ASHLAND AVENUE	E-W	Public Street
		109	6805			
		110	6809			
		111	6813			
		112	6817			
		113	6821			
		114	437	CAPERTINO STREET	N-W	Public Street
		115	441			
		116	445			
		117	449			

STREETS WITH NO ADDRESSES: Alta Drive, Lorenzi Street, Rainbow Boulevard

JR:dp

 JIM ROBISON
 PLANNING ASSISTANT

LEWIS HOMES - STONEGATE NO. 3

Street Listing

APRIL 5, 1984

L-34-4

BLOCK	C	LOT				
		1	448	CAPERTINO STREET	N-W	Public Street
		2	444			
		3	440			
		4	436			
		5	432			
		6	6828	ASHLAND AVENUE	E-W	Public Street
		7	6824			
		8	6820			
		9	6816			
		10	6812			
		11	6808			
		12	6804			
		13	6800			
		14	6801	MIDPARK CIRCLE	E-W	Public Street
		15	6805			
		16	6809			
		17	6813			
		18	6817			
		19	6821			
		20	6825			
		21	6829			
		22	6833			
		23	6832			
		24	6828			
		25	6824			
		26	6820			
		27	6816			
		28	6812			
		29	6808			
		30	6804			
		31	6800			
		32	352	WARMSIDE DRIVE	N-S	Public Street
		33	348			
		34	344			
		35	340			
		36	336			
		37	332			
		38	328			
		39	324			
		40	320			
		41	316			
		42	6801	SPEARFISH AVENUE	E-W	Public Street
		43	6805			
		44	6809			
		45	6813			
		46	6817			
		47	6821			
		48	309	MANOR STREET	N-S	Public Street
		49	313			
		50	317			
		51	321			
		52	325			
		53	329			
		54	333			
		55	337			
		56	6821	SWEETWATER PLACE	E-W	Public Street
		57	6825			
		58	6829			
		59	6833			

LEWIS HOMES - STONEGATE NO. 3
 Street Listing
 April 5, 1984
 Page 2

L-34-4

BLOCK	D	LOT				
		6D	320	MANOR STREET	N-S	Public Street
		61	316			
		62	312			
		63	308			
		64	304			
		65	300			
		66	6824	SPEARFISH AVENUE	E-W	Public Street
		67	6820			
		68	6816			
		69	6812			
		70	6808			
		71	6804			
		72	6800			
		73	301	WARMSIDE DRIVE	N-S	Public Street
		74	305			
		75	309			
		76	313			
		77	317			
		78	321			
		79	325			
		80	329			
		81	333			
		82	337			
		83	341			
		84	345			
		85	349			
		86	353			
		87	357			
		88	361			
		89	365			
		90	401			
		91	405			
		92	409			
		93	413			
		94	417			
		95	421			
		96	425			
		97	429			
		98	433			
		99	437			
		100	441			
		101	445			
		102	449			
		103	453			
		104	452			
		105	448			
		106	444			
		107	440			
		108	6801	ASHLAND AVENUE	E-W	Public Street
		109	6805			
		110	6809			
		111	6813			
		112	6817			
		113	6821			
		114	437	CAPERTINO STREET	N-W	Public Street
		115	441			
		116	445			
		117	449			

STREETS WITH NO ADDRESSES: Alta Drive, Lorenzi Street, Rainbow Boulevard

JR:dp

 JIM ROBISON
 PLANNING ASSISTANT

LEWIS HOMES - STONEGATE NO. 3

Street Listing

APRIL 5, 1984

L-34-4

BLOCK	C	LOT					
		1	448	CAPERTINO STREET	N-W	Public Street	
		2	444				
		3	440				
		4	436				
		5	432				
		6	6828	ASHLAND AVENUE	E-W	Public Street	
		7	6824				
		8	6820				
		9	6816				
		10	6812				
		11	6808				
		12	6804				
		13	6800				
		14	6801	MIDPARK CIRCLE	E-W	Public Street	
		15	6805				
		16	6809				
		17	6813				
		18	6817				
		19	6821				
		20	6825				
		21	6829				
		22	6833				
		23	6832				
		24	6828				
		25	6824				
		26	6820				
		27	6816				
		28	6812				
		29	6808				
		30	6804				
		31	6800				
		32	352	WARMSIDE DRIVE	N-S	Public Street	
		33	348				
		34	344				
		35	340				
		36	336				
		37	332				
		38	328				
		39	324				
		40	320				
		41	316				
		42	6801	SPEARFISH AVENUE	E-W	Public Street	
		43	6805				
		44	6809				
		45	6813				
		46	6817				
		47	6821				
		48	309	MANOR STREET	N-S	Public Street	
		49	313				
		50	317				
		51	321				
		52	325				
		53	329				
		54	333				
		55	337				
		56	6821	SWEETWATER PLACE	E-W	Public Street	
		57	6825				
		58	6829				
		59	6833				

LEWIS HOMES - STONEGATE NO. 3
 Street Listing
 April 5, 1984
 Page 2

L-34-4

BLOCK	D	LOT	ADDRESS	STREET TYPE	STATUS
		60	320	MANOR STREET	N-S Public Street
		61	316		
		62	312		
		63	308		
		64	304		
		65	300		
		66	6824	SPEARFISH AVENUE	E-W Public Street
		67	6820		
		68	6816		
		69	6812		
		70	6808		
		71	6804		
		72	6800		
		73	301	WARMSIDE DRIVE	N-S Public Street
		74	305		
		75	309		
		76	313		
		77	317		
		78	321		
		79	325		
		80	329		
		81	333		
		82	337		
		83	341		
		84	345		
		85	349		
		86	353		
		87	357		
		88	361		
		89	365		
		90	401		
		91	405		
		92	409		
		93	413		
		94	417		
		95	421		
		96	425		
		97	429		
		98	433		
		99	437		
		100	441		
		101	445		
		102	449		
		103	453		
		104	452		
		105	448		
		106	444		
		107	440		
		108	6801	ASHLAND AVENUE	E-W Public Street
		109	6805		
		110	6809		
		111	6813		
		112	6817		
		113	6821		
		114	437	CAPERTINO STREET	N-W Public Street
		115	441		
		116	445		
		117	449		

STREETS WITH NO ADDRESSES: Alta Drive, Lorenzi Street, Rainbow Boulevard

JR:dp

 JIM ROBISON
 PLANNING ASSISTANT

LEWIS HOMES - STONEGATE NO. 3

Street Listing

APRIL 5, 1984

L-34-4

BLOCK	C	LOT					
		1	448	CAPERTINO STREET	N-W	Public Street	
		2	444				
		3	440				
		4	436				
		5	432				
		6	6828	ASHLAND AVENUE	E-W	Public Street	
		7	6824				
		8	6820				
		9	6816				
		10	6812				
		11	6808				
		12	6804				
		13	6800				
		14	6801	MIDPARK CIRCLE	E-W	Public Street	
		15	6805				
		16	6809				
		17	6813				
		18	6817				
		19	6821				
		20	6825				
		21	6829				
		22	6833				
		23	6832				
		24	6828				
		25	6824				
		26	6820				
		27	6816				
		28	6812				
		29	6808				
		30	6804				
		31	6800				
		32	352	WARMSIDE DRIVE	N-S	Public Street	
		33	348				
		34	344				
		35	340				
		36	336				
		37	332				
		38	328				
		39	324				
		40	320				
		41	316				
		42	6801	SPEARFISH AVENUE	E-W	Public Street	
		43	6805				
		44	6809				
		45	6813				
		46	6817				
		47	6821				
		48	309	MANOR STREET	N-S	Public Street	
		49	313				
		50	317				
		51	321				
		52	325				
		53	329				
		54	333				
		55	337				
		56	6821	SWEETWATER PLACE	E-W	Public Street	
		57	6825				
		58	6829				
		59	6833				

LEWIS HOMES - STONEGATE NO. 3
 Street Listing
 April 5, 1984
 Page 2

L-34-4

BLOCK	D	LOT				
		60	320	MANOR STREET	N-S	Public Street
		61	316			
		62	312			
		63	308			
		64	304			
		65	300			
		66	6824	SPEARFISH AVENUE	E-W	Public Street
		67	6820			
		68	6816			
		69	6812			
		70	6808			
		71	6804			
		72	6800			
		73	301	WARMSIDE DRIVE	N-S	Public Street
		74	305			
		75	309			
		76	313			
		77	317			
		78	321			
		79	325			
		80	329			
		81	333			
		82	337			
		83	341			
		84	345			
		85	349			
		86	353			
		87	357			
		88	361			
		89	365			
		90	401			
		91	405			
		92	409			
		93	413			
		94	417			
		95	421			
		96	425			
		97	429			
		98	433			
		99	437			
		100	441			
		101	445			
		102	449			
		103	453			
		104	452			
		105	448			
		106	444			
		107	440			
		108	6801	ASHLAND AVENUE	E-W	Public Street
		109	6805			
		110	6809			
		111	6813			
		112	6817			
		113	6821			
		114	437	CAPERTINO STREET	N-W	Public Street
		115	441			
		116	445			
		117	449			

STREETS WITH NO ADDRESSES: Alta Drive, Lorenzi Street, Rainbow Boulevard

JR:dp

 JIM ROBISON
 PLANNING ASSISTANT

LEWIS HOMES - STONEGATE NO. 3
 Street Listing
 April 5, 1984
 Page 2

					L-34-4	
BLOCK	D	LOT				
		60	320	MANOR STREET	N-S	Public Street
		61	316			
		62	312			
		63	308			
		64	304			
		65	300			
		66	6824	SPEARFISH AVENUE	E-W	Public Street
		67	6820			
		68	6816			
		69	6812			
		70	6808			
		71	6804			
		72	6800			
		73	301	WARMSIDE DRIVE	N-S	Public Street
		74	305			
		75	309			
		76	313			
		77	317			
		78	321			
		79	325			
		80	329			
		81	333			
		82	337			
		83	341			
		84	345			
		85	349			
		86	353			
		87	357			
		88	361			
		89	365			
		90	401			
		91	405			
		92	409			
		93	413			
		94	417			
		95	421			
		96	425			
		97	429			
		98	433			
		99	437			
		100	441			
		101	445			
		102	449			
		103	453			
		104	452			
		105	448			
		106	444			
		107	440			
		108	6801	ASHLAND AVENUE	E-W	Public Street
		109	6805			
		110	6809			
		111	6813			
		112	6817			
		113	6821			
		114	437	CAPERTINO STREET	N-W	Public Street
		115	441			
		116	445			
		117	449			

STREETS WITH NO ADDRESSES: Alta Drive, Lorenzi Street, Rainbow Boulevard

JR:dp

 JIM ROBISON
 PLANNING ASSISTANT

1869855

G. C. WALLACE, Consulting Engineers, Inc.

5543.8230A

April 16, 1984

1100 EAST SAHARA AVENUE

LAS VEGAS, NEVADA 89104

TELEPHONE 702-732-3330

Mr. C. D. Peterson
 Chief of Surveying
 Department of Engineering Services
 Las Vegas City Hall
 400 East Stewart Avenue
 Las Vegas, Nevada 89101

G. C. WALLACE, P.E.
 MICHAEL RADOJEVICH
 KAY L. ADAMS, L.S.
 GARY J. SPINKELINK
 THOMAS COYLE, A.I.A.
 THOMAS E. TRABERT, S.E.

Subject: Certificate of Amendment

Dear Mr. Peterson:

In accordance with the provisions of N.R.S. No. 278.460, Section 27, it is herewith requested that the subdivision plat of Lewis Homes-Stonegate No. 3, as shown by a plat thereof, recorded March 22, 1984, in the Clark County Recorder's Office as Page 28 of Book 31 of plats, be amended in the following manner:




1. The lot lying between lots 52 and 54 be designated as Lot 53 and the straight portion of the front property line of the same lot be shown as having a length of 3.70 feet. Also, the lot lying between lots 57 and 59 be designated as Lot 58. (See Exhibit "A" attached hereto for details).
2. The Northwestern line of lot 73 be shown as having a length of 147.96 feet and the Southeasterly line of lot 72 be shown as having a length of 155.81 feet. (See Exhibit "B" attached hereto for details).
3. The total length of the North lines of lots 6 through 13 (being also the South lines of lots 14 through 22) be shown as having a length of 410.75 feet. Also, the total of the straight portions of the East line of lots 107 and 108 be shown as having a length of 109.57 feet. (See Exhibit "C" attached hereto for details).

Very truly yours,

G. C. WALLACE, CONSULTING ENGINEERS, INC.

Kay L. Adams
 Kay L. Adams
 Registered Land Surveyor
 R.L.S. #2050

/ml
 Attachments

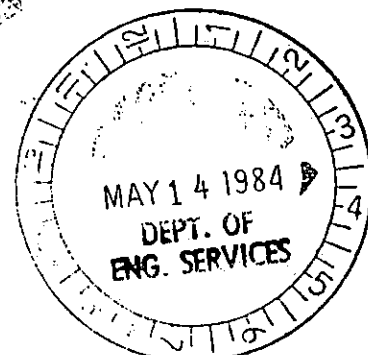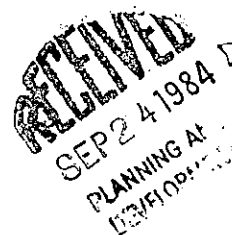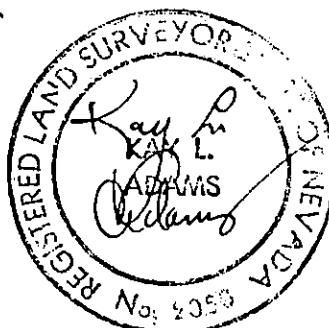

BOOK 1910


1869855

G. C. WALLACE, Consulting Engineers, Inc.

City Surveyor's Certificate


I hereby certify that I have examined this certificate of amendment and that the changes to the original document specified therein are provided for in applicable sections of N.R.S. 278.010 to 279.630 inclusive, N.R.S. 625.340 to 625.380 inclusive, and local ordinances adopted pursuant thereto, and I am satisfied that this certificate of amendment so amends the document as to make it technically correct.

Carl D. Peterson
Carl D. Peterson
R.L.S. #6204

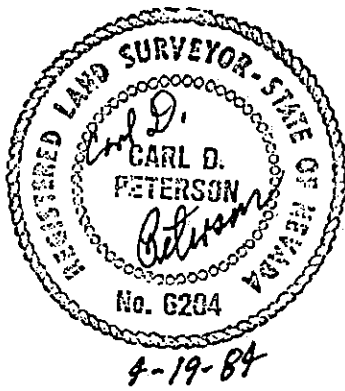

WHEN RECORDED MAIL TO:
CITY CLERK — CITY HALL
400 EAST STEWART AVENUE
LAS VEGAS, NEVADA 89101


ATT: R/W Section

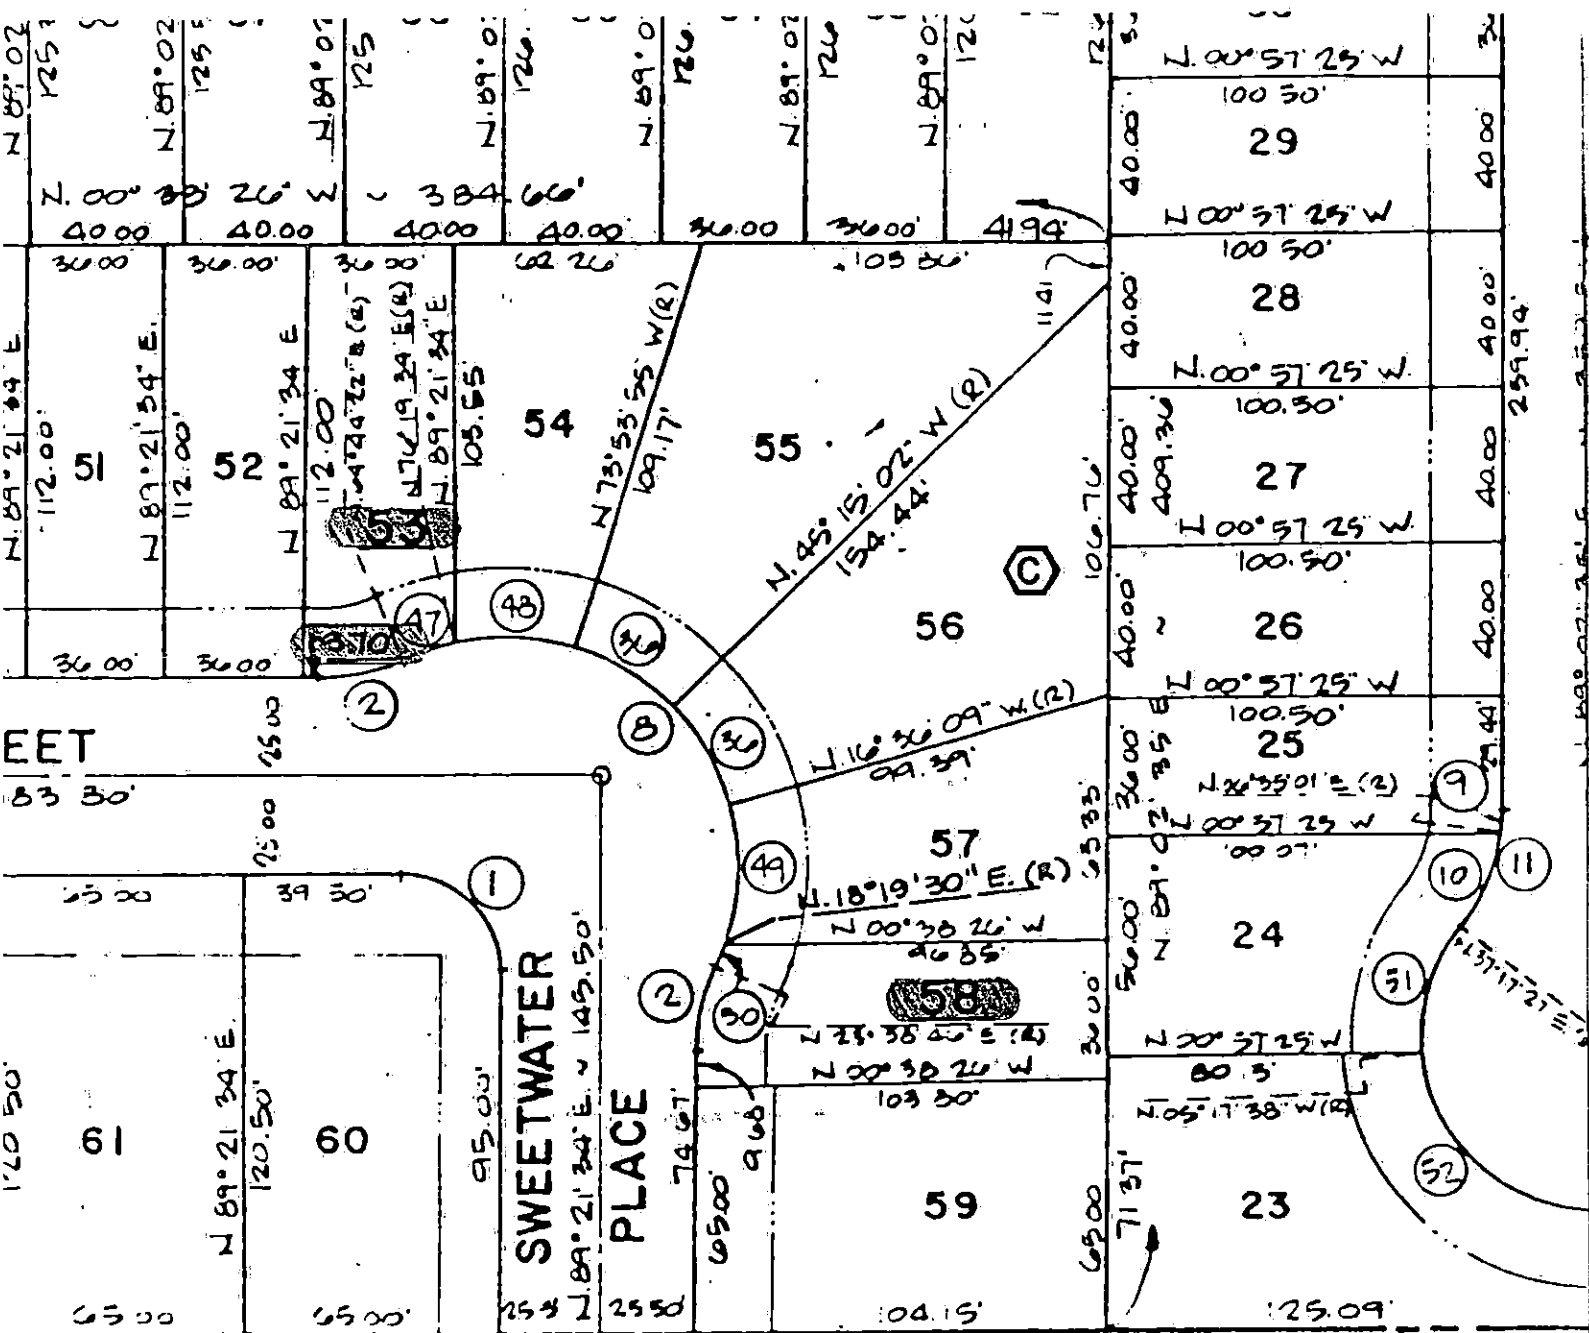

CHARLESTON RAINBOW UNIT 6A
 BOOK 11 PAGE 32

LEWIS HOMES-STONEGATE NO. 3
 (Certificate of Amendment)

EXHIBIT "A"


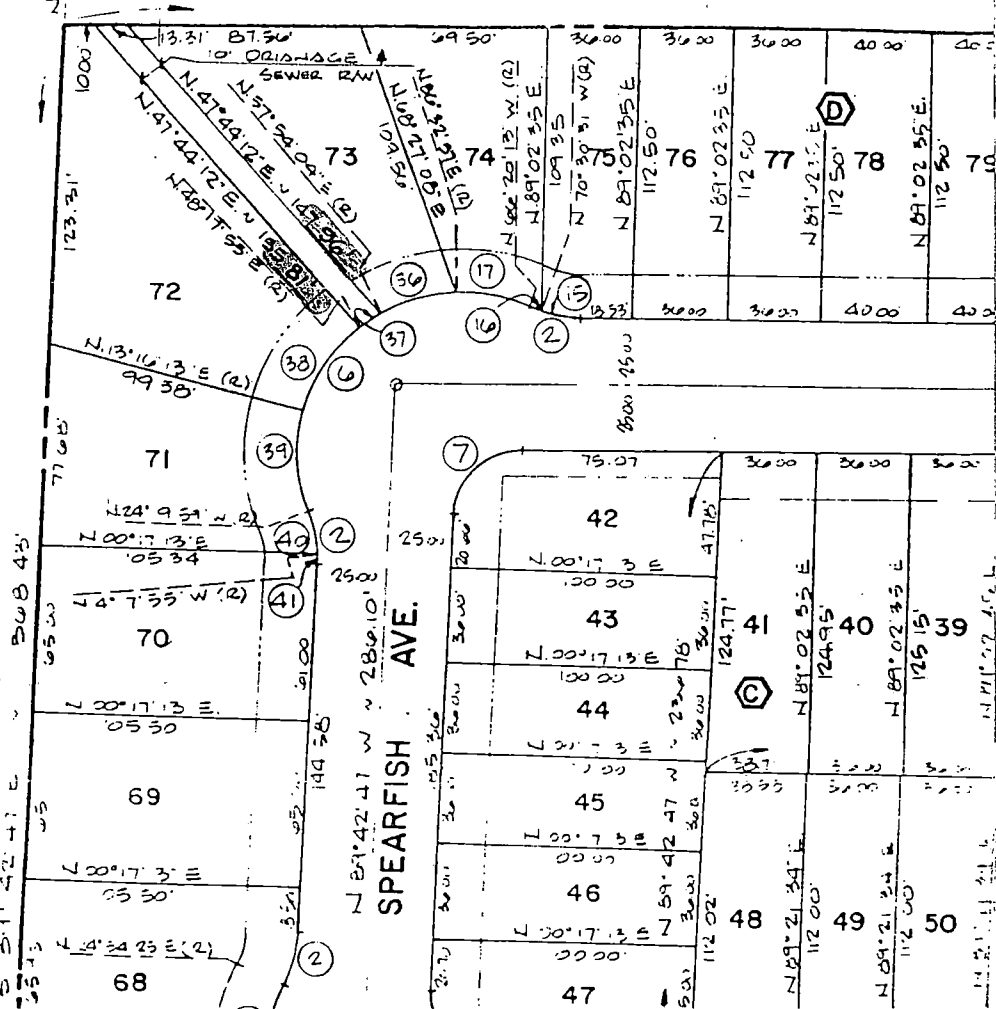


LEWIS HOMES-STONEGATE NO. 3
(Certificate of Amendment)

EXHIBIT "B"

DRIVE

251.00'

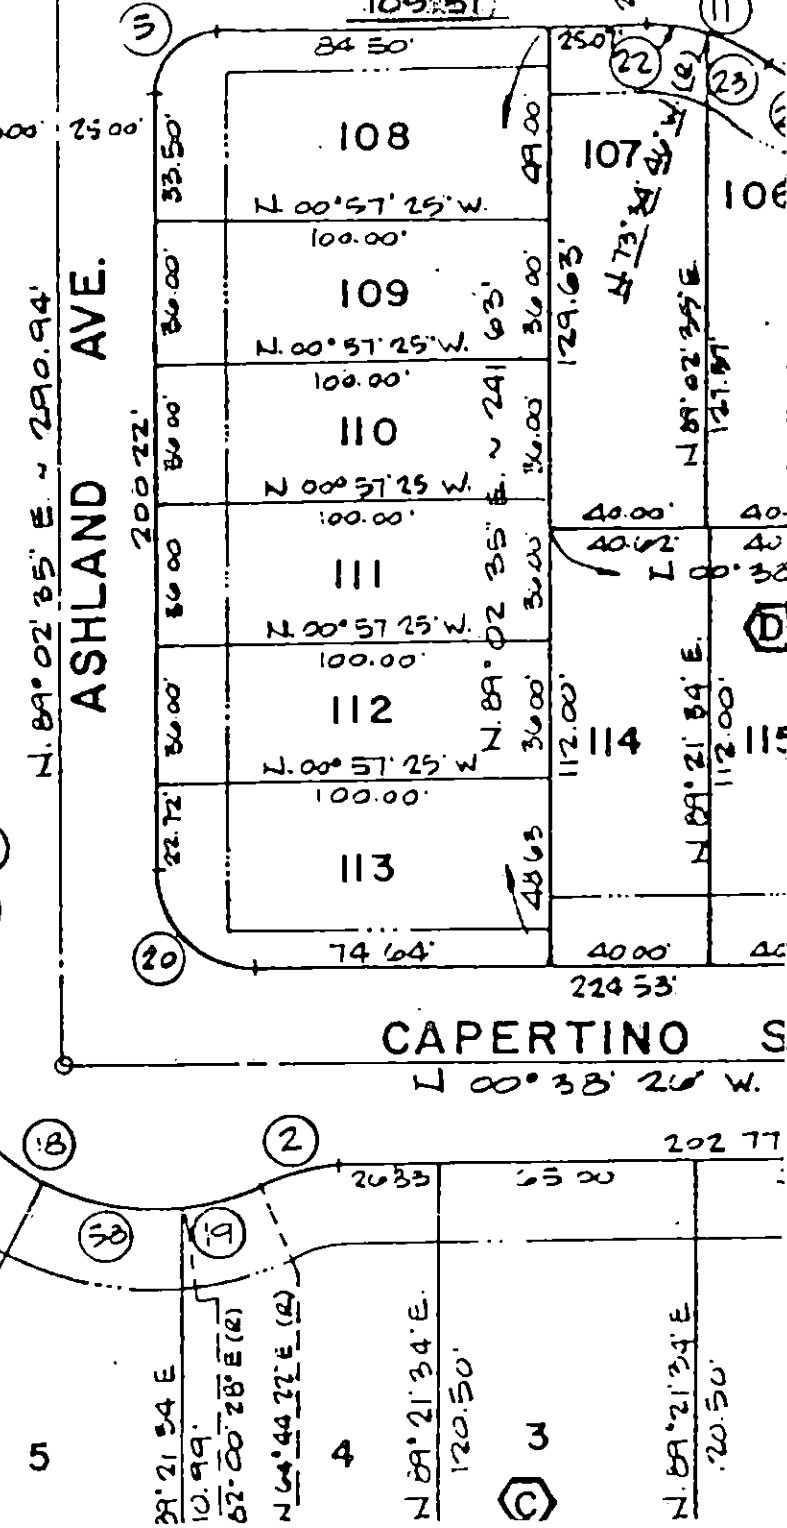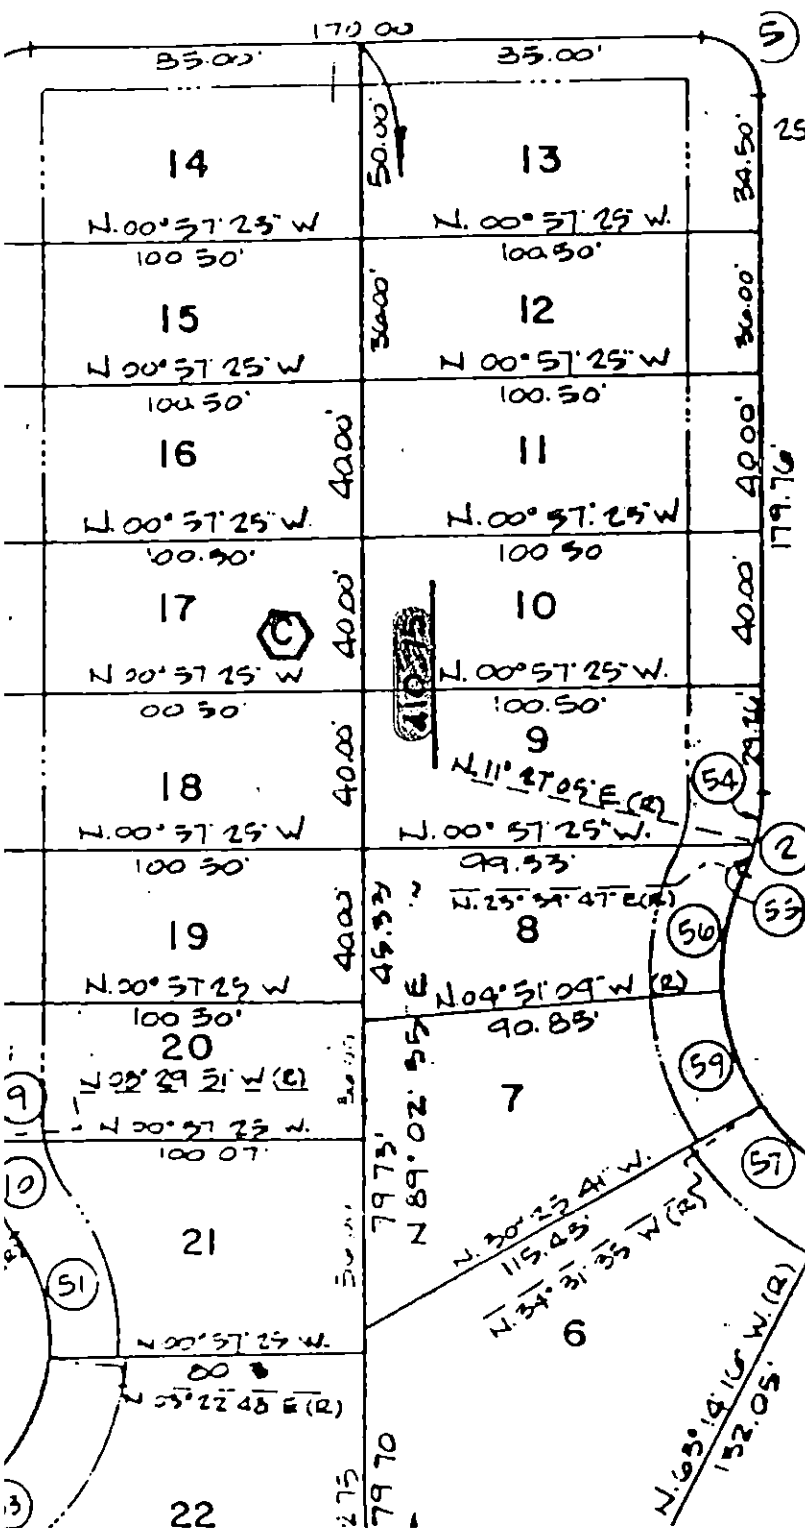


LEWIS HOMES-STONEGATE NO. 3
(Certificate of Amendment)

EXHIBIT "C"

869 1910

869855
66

RECEIVED
MAY 11 11 50 AM '84
CITY CLERK

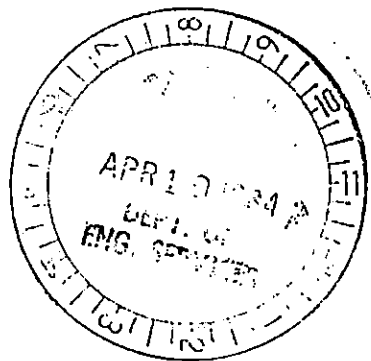

CLARK COUNTY, NEVADA
JOAN L. SWIFT, RECORDER
RECORDED AT REQUEST OF

CITY OF LAS VEGAS

APR 25 9 20 AM '84

FEE DEPUTY
OFFICIAL RECORDS
BOOK INSTRUMENT

1910 869855