


2523

2523

© City of Las Vegas 05/21/04

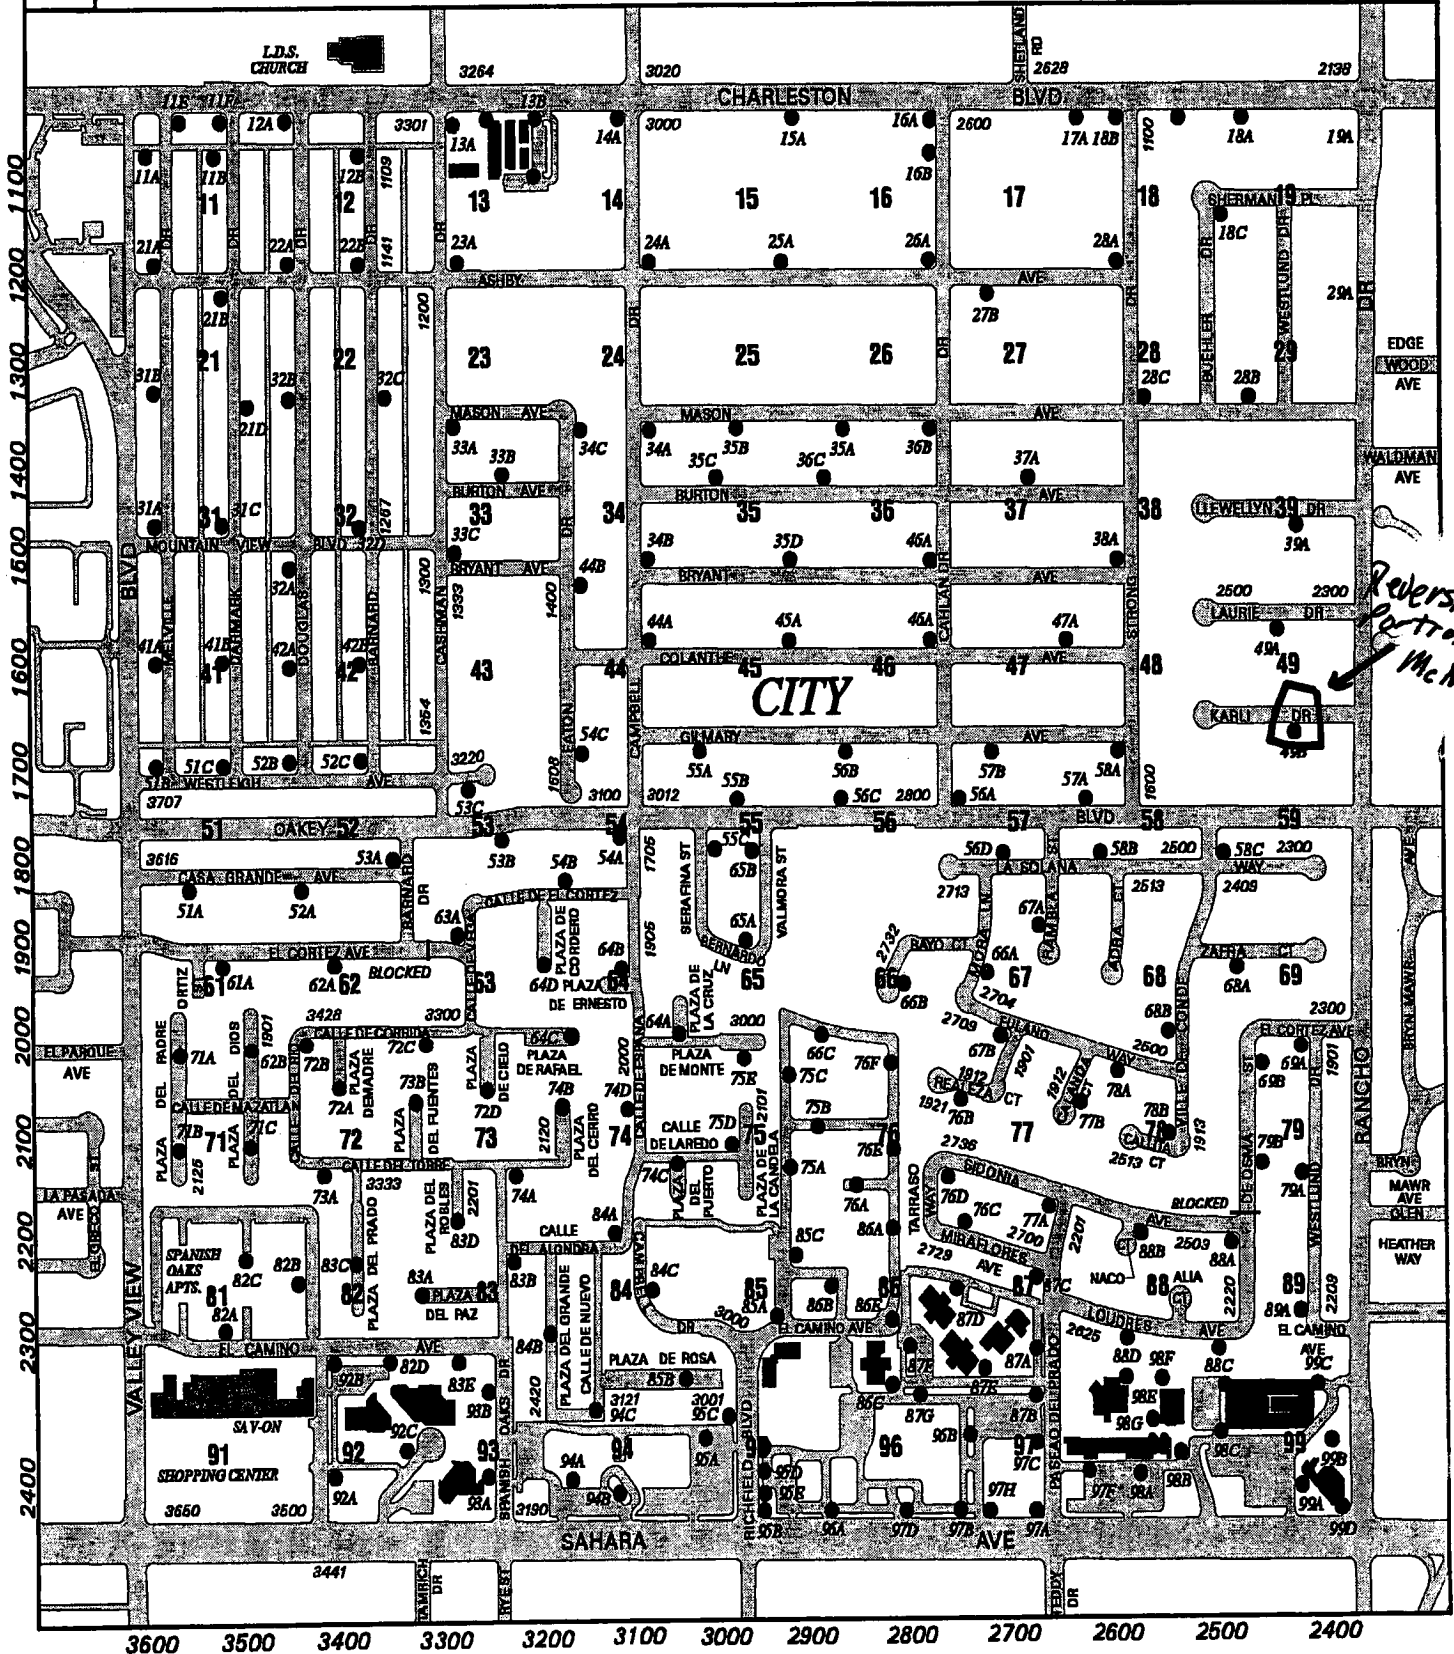

*Reversimary
Patton Ct
McNeil Park*