

TENAYA EAST NO. 1A BY LEWIS HOMES

JANUARY 9, 1991

L-22-6, 8

BLOCK B	LOT	26	1809	SIERRA HILLS WAY	N/S	PUBLIC STREET
		27	1813			
		28	1817			
		29	1821			
		30	1825			
		31	1829			
		32	1833			
		33	1837			
		34	1901			
		35	1905			
		36	1909			
		37	1913			
		38	1917			
		39	1921			
		40	1925			
BLOCK C	LOT	41	7248	OLD MISSION DRIVE	E/W	PUBLIC STREET
		42	7244			
		43	7240			
		44	7236			
		45	7232			
		46	7228			
		47	7224			
		48	7220			
		49	7216			
		50	7212			
		51	7208			
		52	7204			
		53	7200			
BLOCK C	LOT	54	1932	LEANING PINE WAY	N/S	PUBLIC STREET
		55	1928			
		56	1924			
		57	1920			
		58	1916			
		59	1912			
		60	1908			
		61	1904			
		62	1900			
BLOCK D	LOT	63	1828	LEANING PINE WAY	N/S	PUBLIC STREET
		64	1824			
		65	1820			
		66	1816			
		67	1812			
BLOCK F	LOT	149	7201	OLD TIME CIRCLE	E/W	PUBLIC STREET
		150	7205			
		151	7209			
		152	7213			
		153	7217			
BLOCK F	LOT	154	1812	SIERRA HILLS WAY	N/S	PUBLIC STREET
		155	1816			
		156	1820			
		157	1824			
		158	1828			
		159	1832			
BLOCK F	LOT	160	7216	OLD TIME CIRCLE	E/W	PUBLIC STREET
		161	7212			
		162	7208			
		163	7204			
		164	7200			

TENAYA EAST NO. 1A BY LEWIS HOMES

PAGE 2
L-22-6, 8

JANUARY 9, 1991

BLOCK F	LOT	165	7201	SUN COVE CIRCLE	E/W	PUBLIC STREET
		166	7205			
		167	7209			
		168	7213			
		169	7217			
BLOCK F	LOT	170	1836	SIERRA HILLS WAY	N/S	PUBLIC STREET
		171	1900			
		172	1904			
		173	1908			
		174	1912			
		175	1916			
BLOCK F	LOT	176	7216	SUN COVE CIRCLE	E/W	PUBLIC STREET
		177	7212			
		178	7208			
		179	7204			
		180	7200			
BLOCK F	LOT	181	7209	OLD MISSION DRIVE	E/W	PUBLIC STREET
		182	7213			
		183	7217			
		184	7221			
		185	7225			
		186	7229			
		187	7233			

STREETS WITH NO ADDRESSES:

TENAYA WAY
WALT LOTT DRIVEN/S PUBLIC STREET
E/W PUBLIC STREETMATT PINJUV
PLANNER

MP/dr

TENAYA EAST NO. 1A BY LEWIS HOMES

JANUARY 9, 1991

L-22-6, 8

BLOCK B	LOT	26	1809	SIERRA HILLS WAY	N/S	PUBLIC STREET
		27	1813			
		28	1817			
		29	1821			
		30	1825			
		31	1829			
		32	1833			
		33	1837			
		34	1901			
		35	1905			
		36	1909			
		37	1913			
		38	1917			
		39	1921			
		40	1925			
BLOCK C	LOT	41	7248	OLD MISSION DRIVE	E/W	PUBLIC STREET
		42	7244			
		43	7240			
		44	7236			
		45	7232			
		46	7228			
		47	7224			
		48	7220			
		49	7216			
		50	7212			
		51	7208			
		52	7204			
		53	7200			
BLOCK C	LOT	54	1932	LEANING PINE WAY	N/S	PUBLIC STREET
		55	1928			
		56	1924			
		57	1920			
		58	1916			
		59	1912			
		60	1908			
		61	1904			
		62	1900			
BLOCK D	LOT	63	1828	LEANING PINE WAY	N/S	PUBLIC STREET
		64	1824			
		65	1820			
		66	1816			
		67	1812			
BLOCK F	LOT	149	7201	OLD TIME CIRCLE	E/W	PUBLIC STREET
		150	7205			
		151	7209			
		152	7213			
		153	7217			
BLOCK F	LOT	154	1812	SIERRA HILLS WAY	N/S	PUBLIC STREET
		155	1816			
		156	1820			
		157	1824			
		158	1828			
		159	1832			
BLOCK F	LOT	160	7216	OLD TIME CIRCLE	E/W	PUBLIC STREET
		161	7212			
		162	7208			
		163	7204			
		164	7200			

TENAYA EAST NO. 1A BY LEWIS HOMES

PAGE 2
L-22-6, 8

JANUARY 9, 1991

BLOCK F	LOT	165	7201	SUN COVE CIRCLE	E/W	PUBLIC STREET
		166	7205			
		167	7209			
		168	7213			
		169	7217			

BLOCK F	LOT	170	1836	SIERRA HILLS WAY	N/S	PUBLIC STREET
		171	1900			
		172	1904			
		173	1908			
		174	1912			
		175	1916			

BLOCK F	LOT	176	7216	SUN COVE CIRCLE	E/W	PUBLIC STREET
		177	7212			
		178	7208			
		179	7204			
		180	7200			

BLOCK F	LOT	181	7209	OLD MISSION DRIVE	E/W	PUBLIC STREET
		182	7213			
		183	7217			
		184	7221			
		185	7225			
		186	7229			
		187	7233			

STREETS WITH NO ADDRESSES:	TENAYA WAY	N/S	PUBLIC STREET
	WALT LOTT DRIVE	E/W	PUBLIC STREET

MATT PINJUV
PLANNER

MP/dr

TENAYA EAST NO. 1A BY LEWIS HOMES

JANUARY 9, 1991

L-22-6, B

BLOCK B	LOT	26	1809	SIERRA HILLS WAY	N/S	PUBLIC STREET
		27	1813			
		28	1817			
		29	1821			
		30	1825			
		31	1829			
		32	1833			
		33	1837			
		34	1901			
		35	1905			
		36	1909			
		37	1913			
		38	1917			
		39	1921			
		40	1925			
BLOCK C	LOT	41	724B	OLD MISSION DRIVE	E/W	PUBLIC STREET
		42	7244			
		43	7240			
		44	7236			
		45	7232			
		46	722B			
		47	7224			
		48	7220			
		49	7216			
		50	7212			
		51	7208			
		52	7204			
		53	7200			
BLOCK C	LOT	54	1932	LEANING PINE WAY	N/S	PUBLIC STREET
		55	1928			
		56	1924			
		57	1920			
		58	1916			
		59	1912			
		60	1908			
		61	1904			
		62	1900			
BLOCK D	LOT	63	1828	LEANING PINE WAY	N/S	PUBLIC STREET
		64	1824			
		65	1820			
		66	1816			
		67	1812			
BLOCK F	LOT	149	7201	OLD TIME CIRCLE	E/W	PUBLIC STREET
		150	7205			
		151	7209			
		152	7213			
		153	7217			
BLOCK F	LOT	154	1812	SIERRA HILLS WAY	N/S	PUBLIC STREET
		155	1816			
		156	1820			
		157	1824			
		158	1828			
		159	1832			
BLOCK F	LOT	160	7216	OLD TIME CIRCLE	E/W	PUBLIC STREET
		161	7212			
		162	7208			
		163	7204			
		164	7200			

TENAYA EAST NO. 1A BY LEWIS HOMES

PAGE 2
L-22-6, 8

JANUARY 9, 1991

BLOCK F	LOT	165	7201	SUN COVE CIRCLE	E/W	PUBLIC STREET
		166	7205			
		167	7209			
		168	7213			
		169	7217			

BLOCK F	LOT	170	1836	SIERRA HILLS WAY	N/S	PUBLIC STREET
		171	1900			
		172	1904			
		173	1908			
		174	1912			
		175	1916			

BLOCK F	LOT	176	7216	SUN COVE CIRCLE	E/W	PUBLIC STREET
		177	7212			
		178	7208			
		179	7204			
		180	7200			

BLOCK F	LOT	181	7209	OLD MISSION DRIVE	E/W	PUBLIC STREET
		182	7213			
		183	7217			
		184	7221			
		185	7225			
		186	7229			
		187	7233			

STREETS WITH NO ADDRESSES:	TENAYA WAY	N/S	PUBLIC STREET
	WALT LOTT DRIVE	E/W	PUBLIC STREET

MATT PINJUV
PLANNER

MP/dr

TENAYA EAST NO. 1A BY LEWIS HOMES

JANUARY 9, 1991

L-22-6, 8

BLOCK B	LOT	26	1809	SIERRA HILLS WAY	N/S	PUBLIC STREET
		27	1813			
		28	1817			
		29	1821			
		30	1825			
		31	1829			
		32	1833			
		33	1837			
		34	1901			
		35	1905			
		36	1909			
		37	1913			
		38	1917			
		39	1921			
		40	1925			
BLOCK C	LOT	41	7248	OLD MISSION DRIVE	E/W	PUBLIC STREET
		42	7244			
		43	7240			
		44	7236			
		45	7232			
		46	7228			
		47	7224			
		48	7220			
		49	7216			
		50	7212			
		51	7208			
		52	7204			
		53	7200			
BLOCK C	LOT	54	1932	LEANING PINE WAY	N/S	PUBLIC STREET
		55	1928			
		56	1924			
		57	1920			
		58	1916			
		59	1912			
		60	1908			
		61	1904			
		62	1900			
BLOCK D	LOT	63	1828	LEANING PINE WAY	N/S	PUBLIC STREET
		64	1824			
		65	1820			
		66	1816			
		67	1812			
BLOCK F	LOT	149	7201	OLD TIME CIRCLE	E/W	PUBLIC STREET
		150	7205			
		151	7209			
		152	7213			
		153	7217			
BLOCK F	LOT	154	1812	SIERRA HILLS WAY	N/S	PUBLIC STREET
		155	1816			
		156	1820			
		157	1824			
		158	1828			
		159	1832			
BLOCK F	LOT	160	7216	OLD TIME CIRCLE	E/W	PUBLIC STREET
		161	7212			
		162	7208			
		163	7204			
		164	7200			

TENAYA EAST NO. 1A BY LEWIS HOMES

PAGE 2
L-22-6, 8

JANUARY 9, 1991

BLOCK F	LOT 165	7201	SUN COVE CIRCLE	E/W	PUBLIC STREET
	166	7205			
	167	7209			
	168	7213			
	169	7217			

BLOCK F	LOT 170	1836	SIERRA HILLS WAY	N/S	PUBLIC STREET
	171	1900			
	172	1904			
	173	1908			
	174	1912			
	175	1916			

BLOCK F	LOT 176	7216	SUN COVE CIRCLE	E/W	PUBLIC STREET
	177	7212			
	178	7208			
	179	7204			
	180	7200			

BLOCK F	LOT 181	7209	OLD MISSION DRIVE	E/W	PUBLIC STREET
	182	7213			
	183	7217			
	184	7221			
	185	7225			
	186	7229			
	187	7233			

STREETS WITH NO ADDRESSES:	TENAYA WAY	N/S	PUBLIC STREET
	WALT LOTT DRIVE	E/W	PUBLIC STREET

MATT PINJUV
PLANNER

MP/dr

TENAYA EAST NO. 1A BY LEWIS HOMES

JANUARY 9, 1991

L-22-6, 8

BLOCK B	LOT	26	1809	SIERRA HILLS WAY	N/S	PUBLIC STREET
		27	1813			
		28	1817			
		29	1821			
		30	1825			
		31	1829			
		32	1833			
		33	1837			
		34	1901			
		35	1905			
		36	1909			
		37	1913			
		38	1917			
		39	1921			
		40	1925			
BLOCK C	LOT	41	7248	OLD MISSION DRIVE	E/W	PUBLIC STREET
		42	7244			
		43	7240			
		44	7236			
		45	7232			
		46	7228			
		47	7224			
		48	7220			
		49	7216			
		50	7212			
		51	7208			
		52	7204			
		53	7200			
BLOCK C	LOT	54	1932	LEANING PINE WAY	N/S	PUBLIC STREET
		55	1928			
		56	1924			
		57	1920			
		58	1916			
		59	1912			
		60	1908			
		61	1904			
		62	1900			
BLOCK D	LOT	63	1828	LEANING PINE WAY	N/S	PUBLIC STREET
		64	1824			
		65	1820			
		66	1816			
		67	1812			
BLOCK F	LOT	149	7201	OLD TIME CIRCLE	E/W	PUBLIC STREET
		150	7205			
		151	7209			
		152	7213			
		153	7217			
BLOCK F	LOT	154	1812	SIERRA HILLS WAY	N/S	PUBLIC STREET
		155	1816			
		156	1820			
		157	1824			
		158	1828			
		159	1832			
BLOCK F	LOT	160	7216	OLD TIME CIRCLE	E/W	PUBLIC STREET
		161	7212			
		162	7208			
		163	7204			
		164	7200			

TENAYA EAST NO. 1A BY LEWIS HOMES

PAGE 2
L-22-6, B

JANUARY 9, 1991

BLOCK F	LOT	165	7201	SUN COVE CIRCLE	E/W	PUBLIC STREET
		166	7205			
		167	7209			
		168	7213			
		169	7217			

BLOCK F	LOT	170	1836	SIERRA HILLS WAY	N/S	PUBLIC STREET
		171	1900			
		172	1904			
		173	1908			
		174	1912			
		175	1916			

BLOCK F	LOT	176	7216	SUN COVE CIRCLE	E/W	PUBLIC STREET
		177	7212			
		178	7208			
		179	7204			
		180	7200			

BLOCK F	LOT	181	7209	OLD MISSION DRIVE	E/W	PUBLIC STREET
		182	7213			
		183	7217			
		184	7221			
		185	7225			
		186	7229			
		187	7233			

STREETS WITH NO ADDRESSES:	TENAYA WAY	N/S	PUBLIC STREET
	WALT LOTT DRIVE	E/W	PUBLIC STREET

MATT PINJUV
PLANNER

MP/dr



G.C. WALLACE, P.E.
TERRILL B. ADAMS
CALVIN L. BLACK, P.E.
JAMES A. DUDDESTEN, P.E.
DAVID HUCKLE, P.E.
JACK H. KUTCHER, P.E.
MICHAEL E. ROSS, P.E.
RONALD R. THOMAS

CHRISTOPHER W. ANDERSON, P.E.
L. STEVEN ANDERSON, P.E.
MICHAEL J. CSIZMADIA, P.E.
MICHAEL S. KOZMUNI, P.E.
DAN STUART DAVIS, ARCHITECT
C. RUSSELL DAVIS, P.E.
HOWARD L. HARRIS, P.E.
MARC A. LEARDINE
SCOTT R. PLUMMER, P.E.
HOWARD K. VANDER MEER, P.E.
MARIE RAINWATER

JIM BAKKDAHL, P.E.
RICHARD G. CLARKE
R. GUY DOTY, P.E.
DOUGLAS M. HANKE
DONALD A. HASELHOF, P.E.
ROBERT J. HERMAN
MICHAEL L. IVES, ASIA
KRISTOFER D. KURPI
MARVIN W. MAIZE
JOHN R. JOHNS, P.E.
SAUNDRA L. VANCE, CCS
STEVEN L. YOUNGBERG, P.E.

5543.7160X

May 30, 1991

Mrs. Rita M. Lumos, P.L.S.
City Surveyor
City of Las Vegas
400 East Stewart Avenue
Las Vegas, Nevada 89101

Subject: Certificate of Amendment - Subdivision Plat of
"Tenaya East No. 1B by Lewis Homes"
Filed October 26, 1990, in Book 47, Page 88 of Plats,
"Tenaya East No. 1A by Lewis Homes"
Filed December 27, 1990, in Book 48, Page 44 of Plats,
in the Clark County Recorder's Office, Clark County, Nevada

Dear Mrs. Lumos:

Please be advised that in accordance with the provisions of N.R.S. Chapter 278.473, it is hereby requested that the subject subdivision plats be amended to delete the landscaping easements, described as follows:

"TENAYA EAST NO. 1A BY LEWIS HOMES"

1. The west 5.00 feet of Lots 26 through 39, inclusive, Block B
2. The west 9.00 feet of Lot 40 Block B
3. The west 9.00 feet of Lot 41 Block C


"TENAYA EAST NO. 1B BY LEWIS HOMES"

1. The west 5.00 feet of Lot 25, Block B
2. The west 9.00 feet of Lot 24, Block B
3. The west 9.00 feet of Lot 23, Block A
4. The west 5.00 feet of Lots 6 through 22, inclusive, Block A
5. The west, southwest, and south 5.00 feet of Lot 5, Block A
6. The south 5.00 feet of Lots 2 through 4, inclusive, Block A
7. The south 9.00 feet of Lot 1, Block A
8. The south 9.00 feet of Lot 95, Block D
9. The south 5.00 feet of Lots 91 through 94, inclusive, Block D

Reference is made to pages 3, 4, 5, 6, 7, and 8 of this document for specific map corrections.

Very truly yours,

Kay L. Adams
Professional Land Surveyor
Nevada Certificate No. 2050

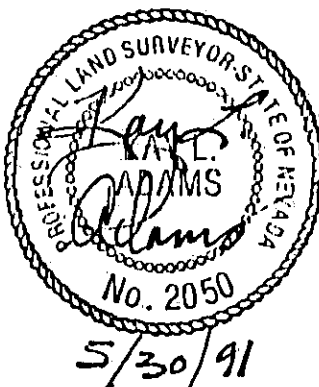

Page 1 of 8


CLARK COUNTY, NEVADA			
JOAN L. SWIFT, RECORDER			
RECORDED AT REQUEST OF:			
GC WALLACE INC			
06-03-91	12:47	CAR	9
BOOK:	910603	INST:	00571
FEE:	.00	RPTT:	1A .00
CA PLAT			
CONFORMED COPY-HAS NOT BEEN COMPARED TO THE ORIGINAL			

Mr. Gary A. Presswood
May 30, 1991

5543.7160X


City Engineer's Certificate

I hereby certify that I have examined the Certificate of Amendment and that the changes to the original document specified therein are provided for in the applicable sections of N.R.S. 278.010 to 278.630 inclusive, N.R.S. 625.340 to 625.380 inclusive and local ordinances adopted pursuant thereto, and I am satisfied that this Certificate of Amendment so amends the document as to make it technically correct.


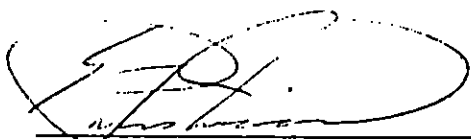


Gary A. Presswood
City Engineer
R.P.E. 7569




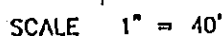



PAGE 3 OF 8

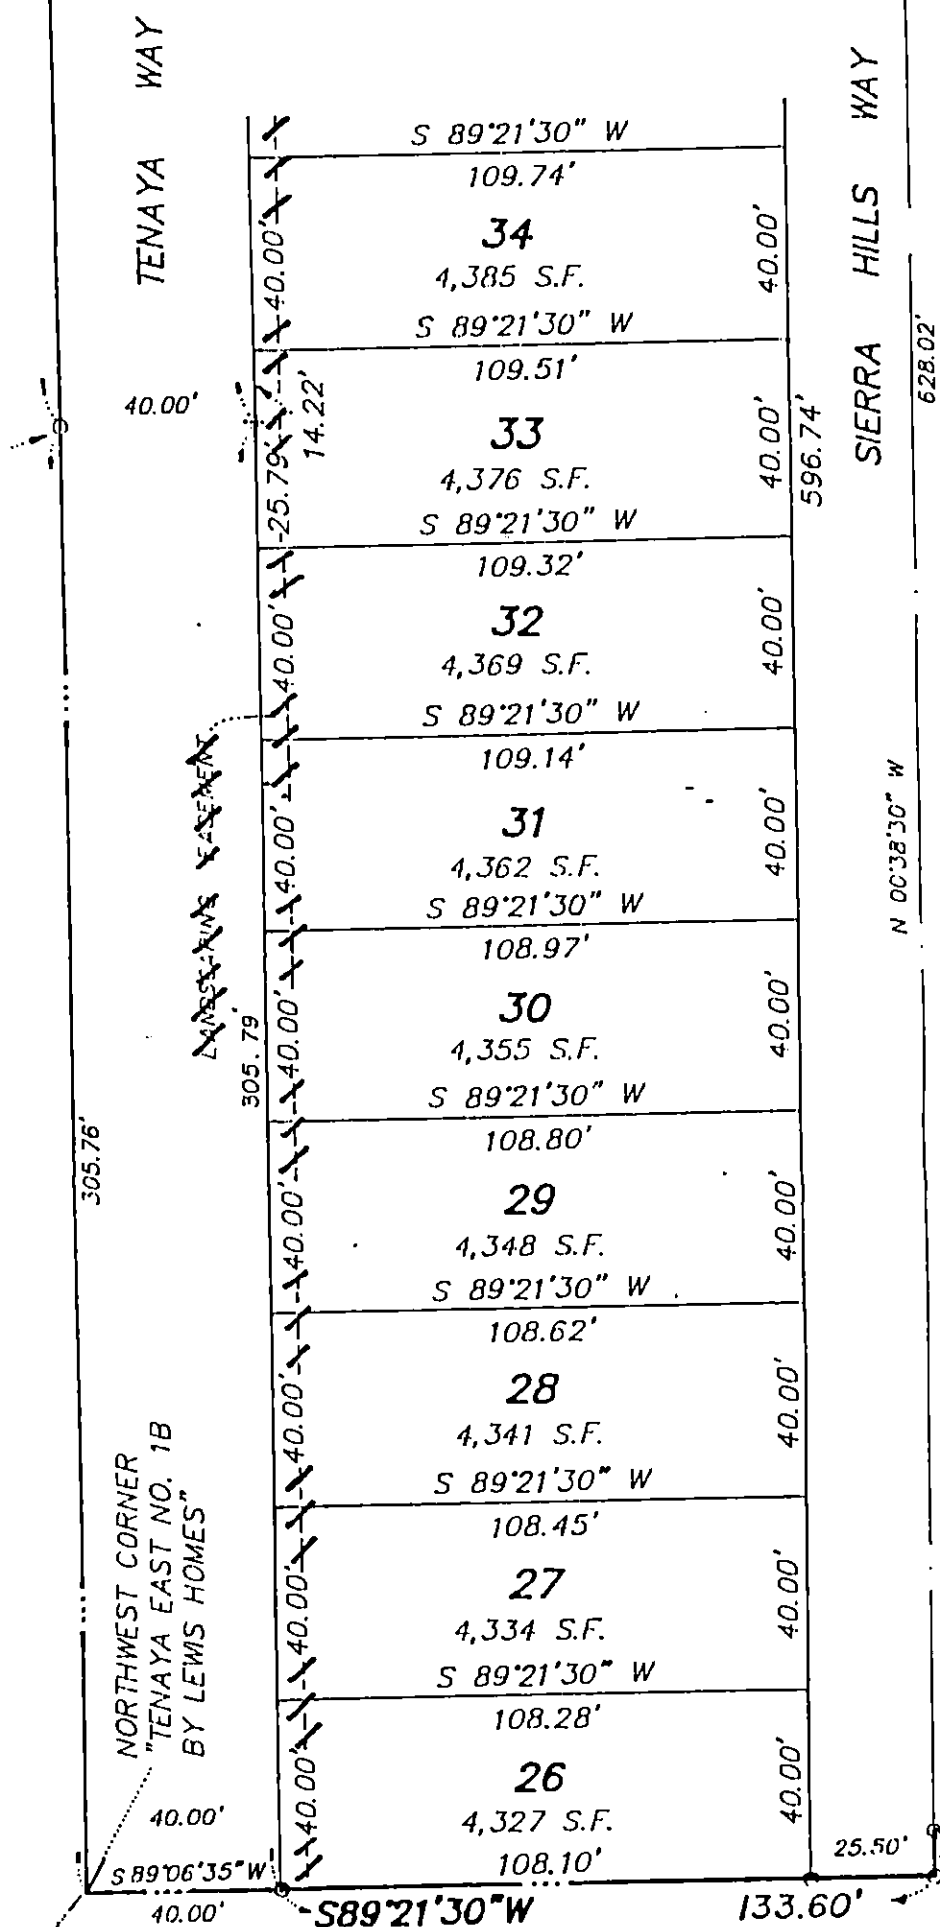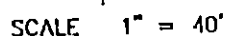


SHEET 3 OF 3 BOOK 48 PAGE 44 OF PLATS

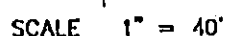


PAGE 5 OF 8

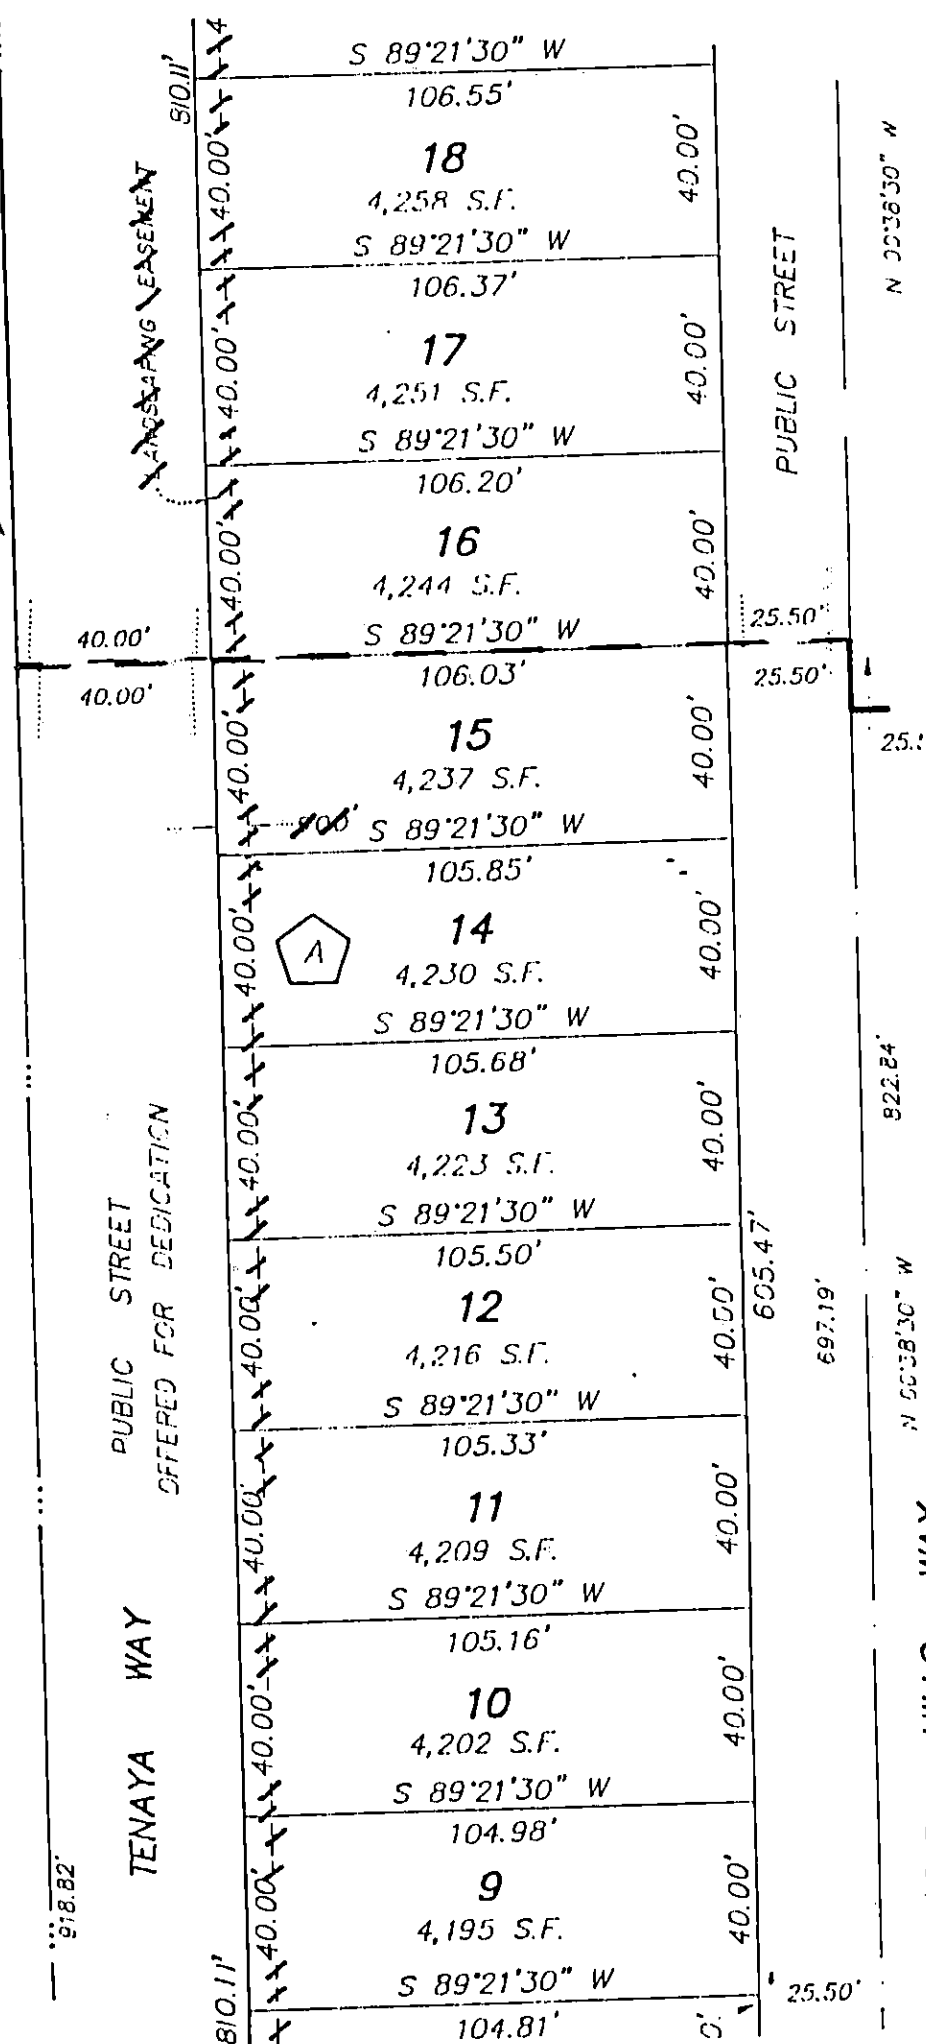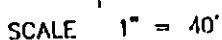


SHEET 3 & 4 OF 4 BOOK 47 PAGE 88 OF PLATS

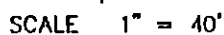

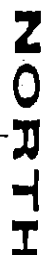

SCALE 1" = 40'

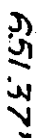

SHEET 4 OF 4 BOOK 47 PAGE 88 OF PLATS