

TENAYA EAST NO. 1B BY LEWIS HOMES

DECEMBER 12, 1990

L-22-B

BLOCK A	LOT	1	7221	SINGLE PINE DRIVE	E/W	PUBLIC STREET
		2	7225			
		3	7229			
		4	7233			
BLOCK A	LOT	5	1601	SIERRA HILLS WAY	N/S	PUBLIC STREET
		6	1605			
		7	1609			
		8	1613			
		9	1617			
		10	1621			
		11	1625			
		12	1629			
		13	1633			
		14	1637			
		15	1701			
		16	1705			
		17	1709			
		18	1713			
		19	1717			
		20	1721			
		21	1725			
		22	1729			
		23	1733			
BLOCK B	LOT	24	1801	SIERRA HILLS WAY	N/S	PUBLIC STREET
		25	1805			
BLOCK D	LOT	68	1808	LEANING PINE WAY	N/S	PUBLIC STREET
		69	1804			
		70	1800			
		71	1740			
		72	1736			
		73	1732			
		74	1728			
		75	1724			
		76	1720			
		77	1716			
		78	1712			
		79	1708			
		80	1704			
		81	1700			
		82	1636			
		83	1632			
		84	1628			
		85	1624			
		86	1620			
		87	1616			
		88	1612			
		89	1608			
		90	1604			
		91	1600			
BLOCK D	LOT	92	7201	SINGLE PINE DRIVE	E/W	PUBLIC STREET
		93	7205			
		94	9209			
		95	7213			
BLOCK E	LOT	96	7228	SINGLE PINE DRIVE	E/W	PUBLIC STREET
		97	7224			
		98	7220			
		99	7216			
		100	7212			
		101	7208			
		102	7204			

TENAYA EAST NO. 1B BY LEWIS HOMES
DECEMBER 12, 1990

PAGE 2
L-22-8

BLOCK E	LOT	103	7201	INDIAN PATH CIRCLE	E/W	PUBLIC STREET
		104	7205			
		105	7209			
		106	7213			
		107	7217			
BLOCK E	LOT	108	1620	SIERRA HILLS WAY	N/S	PUBLIC STREET
		109	1624			
		110	1628			
		111	1632			
		112	1636			
		113	1700			
BLOCK E	LOT	114	7216	INDIAN PATH CIRCLE	E/W	PUBLIC STREET
		115	7212			
		116	7208			
		117	7204			
		118	7200			
BLOCK E	LOT	119	7201	LONESOME CIRCLE	E/W	PUBLIC STREET
		120	7205			
		121	7209			
		122	7213			
		123	7217			
BLOCK E	LOT	124	1704	SIERRA HILLS WAY	E/W	PUBLIC STREET
		125	1708			
		126	1712			
		127	1716			
		128	1720			
		129	1724			
BLOCK E	LOT	130	7216	LONESOME CIRCLE	E/W	PUBLIC STREET
		131	7212			
		132	7208			
		133	7204			
		134	7200			
BLOCK E	LOT	135	7201	SCENIC HILLS DRIVE	E/W	PUBLIC STREET
		136	7205			
		137	7209			
		138	7213			
		139	7217			
		140	7221			
		141	7225			
BLOCK F	LOT	142	7224	SCENIC HILLS DRIVE	E/W	PUBLIC STREET
		143	7220			
		144	7216			
		145	7212			
		146	7208			
		147	7204			
		148	7200			
STREETS WITH NO ADDRESSES:				TENAYA WAY	N/S	PUBLIC STREET
				VEGAS DRIVE	E/W	PUBLIC STREET

LC/dr

 LES COMEAU,
SENIOR PLANNER

TENAYA EAST NO. 1B BY LEWIS HOMES

DECEMBER 12, 1990

L-22-8

BLOCK A	LOT	1	7221	SINGLE PINE DRIVE	E/W	PUBLIC STREET
		2	7225			
		3	7229			
		4	7233			
BLOCK A	LOT	5	1601	SIERRA HILLS WAY	N/S	PUBLIC STREET
		6	1605			
		7	1609			
		8	1613			
		9	1617			
		10	1621			
		11	1625			
		12	1629			
		13	1633			
		14	1637			
		15	1701			
		16	1705			
		17	1709			
		18	1713			
		19	1717			
		20	1721			
		21	1725			
		22	1729			
		23	1733			
BLOCK B	LOT	24	1801	SIERRA HILLS WAY	N/S	PUBLIC STREET
		25	1805			
BLOCK D	LOT	68	1808	LEANING PINE WAY	N/S	PUBLIC STREET
		69	1804			
		70	1800			
		71	1740			
		72	1736			
		73	1732			
		74	1728			
		75	1724			
		76	1720			
		77	1716			
		78	1712			
		79	1708			
		80	1704			
		81	1700			
		82	1636			
		83	1632			
		84	1628			
		85	1624			
		86	1620			
		87	1616			
		88	1612			
		89	1608			
		90	1604			
		91	1600			
BLOCK D	LOT	92	7201	SINGLE PINE DRIVE	E/W	PUBLIC STREET
		93	7205			
		94	9209			
		95	7213			
BLOCK E	LOT	96	7228	SINGLE PINE DRIVE	E/W	PUBLIC STREET
		97	7224			
		98	7220			
		99	7216			
		100	7212			
		101	7208			
		102	7204			

BLOCK E	LOT	103	7201	INDIAN PATH CIRCLE	E/W	PUBLIC STREET
		104	7205			
		105	7209			
		106	7213			
		107	7217			
BLOCK E	LOT	108	1620	SIERRA HILLS WAY	N/S	PUBLIC STREET
		109	1624			
		110	1628			
		111	1632			
		112	1636			
		113	1700			
BLOCK E	LOT	114	7216	INDIAN PATH CIRCLE	E/W	PUBLIC STREET
		115	7212			
		116	7208			
		117	7204			
		118	7200			
BLOCK E	LOT	119	7201	LONESOME CIRCLE	E/W	PUBLIC STREET
		120	7205			
		121	7209			
		122	7213			
		123	7217			
BLOCK E	LOT	124	1704	SIERRA HILLS WAY	E/W	PUBLIC STREET
		125	1708			
		126	1712			
		127	1716			
		128	1720			
		129	1724			
BLOCK E	LOT	130	7216	LONESOME CIRCLE	E/W	PUBLIC STREET
		131	7212			
		132	7208			
		133	7204			
		134	7200			
BLOCK E	LOT	135	7201	SCENIC HILLS DRIVE	E/W	PUBLIC STREET
		136	7205			
		137	7209			
		138	7213			
		139	7217			
		140	7221			
		141	7225			
BLOCK F	LOT	142	7224	SCENIC HILLS DRIVE	E/W	PUBLIC STREET
		143	7220			
		144	7216			
		145	7212			
		146	7208			
		147	7204			
		148	7200			
STREETS WITH NO ADDRESSES:				TENAYA WAY	N/S	PUBLIC STREET
				VEGAS DRIVE	E/W	PUBLIC STREET

LES COMEAU,
SENIOR PLANNER

LC/dr

TENAYA EAST NO. 1B BY LEWIS HOMES

DECEMBER 12, 1990

L-22-8

BLOCK A	LOT	1	7221	SINGLE PINE DRIVE	E/W	PUBLIC STREET
		2	7225			
		3	7229			
		4	7233			
BLOCK A	LOT	5	1601	SIERRA HILLS WAY	N/S	PUBLIC STREET
		6	1605			
		7	1609			
		8	1613			
		9	1617			
		10	1621			
		11	1625			
		12	1629			
		13	1633			
		14	1637			
		15	1701			
		16	1705			
		17	1709			
		18	1713			
		19	1717			
		20	1721			
		21	1725			
		22	1729			
		23	1733			
BLOCK B	LOT	24	1801	SIERRA HILLS WAY	N/S	PUBLIC STREET
		25	1805			
BLOCK D	LOT	68	1808	LEANING PINE WAY	N/S	PUBLIC STREET
		69	1804			
		70	1800			
		71	1740			
		72	1736			
		73	1732			
		74	1728			
		75	1724			
		76	1720			
		77	1716			
		78	1712			
		79	1708			
		80	1704			
		81	1700			
		82	1636			
		83	1632			
		84	1628			
		85	1624			
		86	1620			
		87	1616			
		88	1612			
		89	1608			
		90	1604			
		91	1600			
BLOCK D	LOT	92	7201	SINGLE PINE DRIVE	E/W	PUBLIC STREET
		93	7205			
		94	9209			
		95	7213			
BLOCK E	LOT	96	7228	SINGLE PINE DRIVE	E/W	PUBLIC STREET
		97	7224			
		98	7220			
		99	7216			
		100	7212			
		101	7208			
		102	7204			

TENAYA EAST NO. 1B BY LEWIS HOMES
DECEMBER 12, 1990

PAGE 2
L-22-8

BLOCK E	LOT	103	7201	INDIAN PATH CIRCLE	E/W	PUBLIC STREET
		104	7205			
		105	7209			
		106	7213			
		107	7217			
BLOCK E	LOT	108	1620	SIERRA HILLS WAY	N/S	PUBLIC STREET
		109	1624			
		110	1628			
		111	1632			
		112	1636			
		113	1700			
BLOCK E	LOT	114	7216	INDIAN PATH CIRCLE	E/W	PUBLIC STREET
		115	7212			
		116	7208			
		117	7204			
		118	7200			
BLOCK E	LOT	119	7201	LONESOME CIRCLE	E/W	PUBLIC STREET
		120	7205			
		121	7209			
		122	7213			
		123	7217			
BLOCK E	LOT	124	1704	SIERRA HILLS WAY	E/W	PUBLIC STREET
		125	1708			
		126	1712			
		127	1716			
		128	1720			
		129	1724			
BLOCK E	LOT	130	7216	LONESOME CIRCLE	E/W	PUBLIC STREET
		131	7212			
		132	7208			
		133	7204			
		134	7200			
BLOCK E	LOT	135	7201	SCENIC HILLS DRIVE	E/W	PUBLIC STREET
		136	7205			
		137	7209			
		138	7213			
		139	7217			
		140	7221			
		141	7225			
BLOCK F	LOT	142	7224	SCENIC HILLS DRIVE	E/W	PUBLIC STREET
		143	7220			
		144	7216			
		145	7212			
		146	7208			
		147	7204			
		148	7200			
STREETS WITH NO ADDRESSES:				TENAYA WAY	N/S	PUBLIC STREET
				VEGAS DRIVE	E/W	PUBLIC STREET

LES COMEAU,
SENIOR PLANNER

LC/dr

TENAYA EAST NO. 1B BY LEWIS HOMES

DECEMBER 12, 1990

L-22-8

BLOCK A	LOT	1	7221	SINGLE PINE DRIVE	E/W	PUBLIC STREET
		2	7225			
		3	7229			
		4	7233			
BLOCK A	LOT	5	1601	SIERRA HILLS WAY	N/S	PUBLIC STREET
		6	1605			
		7	1609			
		8	1613			
		9	1617			
		10	1621			
		11	1625			
		12	1629			
		13	1633			
		14	1637			
		15	1701			
		16	1705			
		17	1709			
		18	1713			
		19	1717			
		20	1721			
		21	1725			
		22	1729			
		23	1733			
BLOCK B	LOT	24	1801	SIERRA HILLS WAY	N/S	PUBLIC STREET
		25	1805			
BLOCK D	LOT	68	1808	LEANING PINE WAY	N/S	PUBLIC STREET
		69	1804			
		70	1800			
		71	1740			
		72	1736			
		73	1732			
		74	1728			
		75	1724			
		76	1720			
		77	1716			
		78	1712			
		79	1708			
		80	1704			
		81	1700			
		82	1636			
		83	1632			
		84	1628			
		85	1624			
		86	1620			
		87	1616			
		88	1612			
		89	1608			
		90	1604			
		91	1600			
BLOCK D	LOT	92	7201	SINGLE PINE DRIVE	E/W	PUBLIC STREET
		93	7205			
		94	9209			
		95	7213			
BLOCK E	LOT	96	7228	SINGLE PINE DRIVE	E/W	PUBLIC STREET
		97	7224			
		98	7220			
		99	7216			
		100	7212			
		101	7208			
		102	7204			

BLOCK E	LOT	103	7201	INDIAN PATH CIRCLE	E/W	PUBLIC STREET
		104	7205			
		105	7209			
		106	7213			
		107	7217			
BLOCK E	LOT	108	1620	SIERRA HILLS WAY	N/S	PUBLIC STREET
		109	1624			
		110	1628			
		111	1632			
		112	1636			
		113	1700			
BLOCK E	LOT	114	7216	INDIAN PATH CIRCLE	E/W	PUBLIC STREET
		115	7212			
		116	7208			
		117	7204			
		118	7200			
BLOCK E	LOT	119	7201	LONESOME CIRCLE	E/W	PUBLIC STREET
		120	7205			
		121	7209			
		122	7213			
		123	7217			
BLOCK E	LOT	124	1704	SIERRA HILLS WAY	E/W	PUBLIC STREET
		125	1708			
		126	1712			
		127	1716			
		128	1720			
		129	1724			
BLOCK E	LOT	130	7216	LONESOME CIRCLE	E/W	PUBLIC STREET
		131	7212			
		132	7208			
		133	7204			
		134	7200			
BLOCK E	LOT	135	7201	SCENIC HILLS DRIVE	E/W	PUBLIC STREET
		136	7205			
		137	7209			
		138	7213			
		139	7217			
		140	7221			
		141	7225			
BLOCK F	LOT	142	7224	SCENIC HILLS DRIVE	E/W	PUBLIC STREET
		143	7220			
		144	7216			
		145	7212			
		146	7208			
		147	7204			
		148	7200			
STREETS WITH NO ADDRESSES:				TENAYA WAY	N/S	PUBLIC STREET
				VEGAS DRIVE	E/W	PUBLIC STREET

LC/dr

LES COMEAU,
SENIOR PLANNER





G.C. WALLACE, INC.
Engineering/Architecture

G.C. WALLACE, PE.
TERRILL B. ADAMS
CARVIN L. BLACK, PE.
JAMES A. DUDDESTON, PE.
DAVID HUCKLE, PE.
JACK H. MITCHELL, PE.
MICHAEL D. RESS, PT.
RONALD R. THOMAS

CHRISTOPHER W. ANDERSON, P.
L. STEVEN ANDERSON, PE.
MICHAEL J. CSIZMADIA, PE.
MICHAEL S. KUZUNIS, PE.
DAN STUART DAVIS, ARCHITECT
C. RUSSELL DAVIS, PE.
HOWARD L. HARRIS, PE.
MARC A. LEAQUINE
SCOTT R. PLUMMER, PE.
HOWARD K. VANDER MEER, PE.
MARIE RAINWATER

5543.7160X

May 30, 1991

Mrs. Rita M. Lumos, P.L.S.
City Surveyor
City of Las Vegas
400 East Stewart Avenue
Las Vegas, Nevada 89101

JIM BAKKEDAH, PE.
RICHARD G. CLARKE
R. GUY FOSTY, PLS.
DOUGLAS M. HANKEL
DONALD A. HANSEN, PT.
ROBERT J. HERNAN
MICHAEL J. IVIN, ASIA
KRISTOFER D. KUBIN
MARVIN W. MAIZI
JOHN R. JOHNS, PE.
SAUNDRA L. VANCE, CCS
STEVEN L. YOUNGBERG, PLS.

Subject: Certificate of Amendment - Subdivision Plat of
"Tenaya East No. 1B by Lewis Homes"
Filed October 26, 1990, in Book 47, Page 88 of Plats,
"Tenaya East No. 1A by Lewis Homes"
Filed December 27, 1990, in Book 48, Page 44 of Plats,
in the Clark County Recorder's Office, Clark County, Nevada

Dear Mrs. Lumos:

Please be advised that in accordance with the provisions of N.R.S. Chapter 278.473, it is hereby requested that the subject subdivision plats be amended to delete the landscaping easements, described as follows:

"TENAYA EAST NO. 1A BY LEWIS HOMES"

1. The west 5.00 feet of Lots 26 through 39, inclusive, Block B
2. The west 9.00 feet of Lot 40 Block B
3. The west 9.00 feet of Lot 41 Block C


"TENAYA EAST NO. 1B BY LEWIS HOMES"

1. The west 5.00 feet of Lot 25, Block B
2. The west 9.00 feet of Lot 24, Block B
3. The west 9.00 feet of Lot 23, Block A
4. The west 5.00 feet of Lots 6 through 22, inclusive, Block A
5. The west, southwest, and south 5.00 feet of Lot 5, Block A
6. The south 5.00 feet of Lots 2 through 4, inclusive, Block A
7. The south 9.00 feet of Lot 1, Block A
8. The south 9.00 feet of Lot 95, Block D
9. The south 5.00 feet of Lots 91 through 94, inclusive, Block D

Reference is made to pages 3, 4, 5, 6, 7, and 8 of this document for specific map corrections.

Very truly yours,

Kay L. Adams
Professional Land Surveyor
Nevada Certificate No. 2050

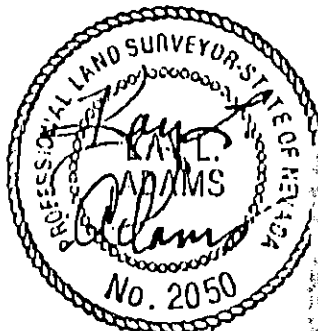

5/30/91

CLARK COUNTY, NEVADA
JOAN L. SWIFT, RECORDER
RECORDED AT REQUEST OF:
GC WALLACE INC


06-03-91 12:47 CAR 9
BOOK: 910603 INST: 00570
FEE: 13.00 RPTT: 15.00
CA PLAT
CONFORMED COPY HAS NOT BEEN COMPARED TO THE ORIGINAL

Mr. Gary A. Presswood
May 30, 1991

5543.7160X


City Engineer's Certificate

I hereby certify that I have examined the Certificate of Amendment and that the changes to the original document specified therein are provided for in the applicable sections of N.R.S. 278.010 to 278.630 inclusive, N.R.S. 625.340 to 625.380 inclusive and local ordinances adopted pursuant thereto, and I am satisfied that this Certificate of Amendment so amends the document as to make it technically correct.

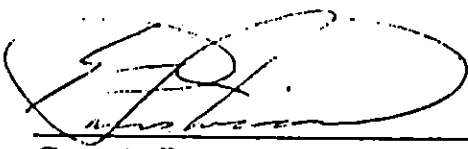

Gary A. Presswood
City Engineer
R.P.E. 7569




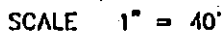

PAGE 3 OF 8




SCALE 1" = 40'

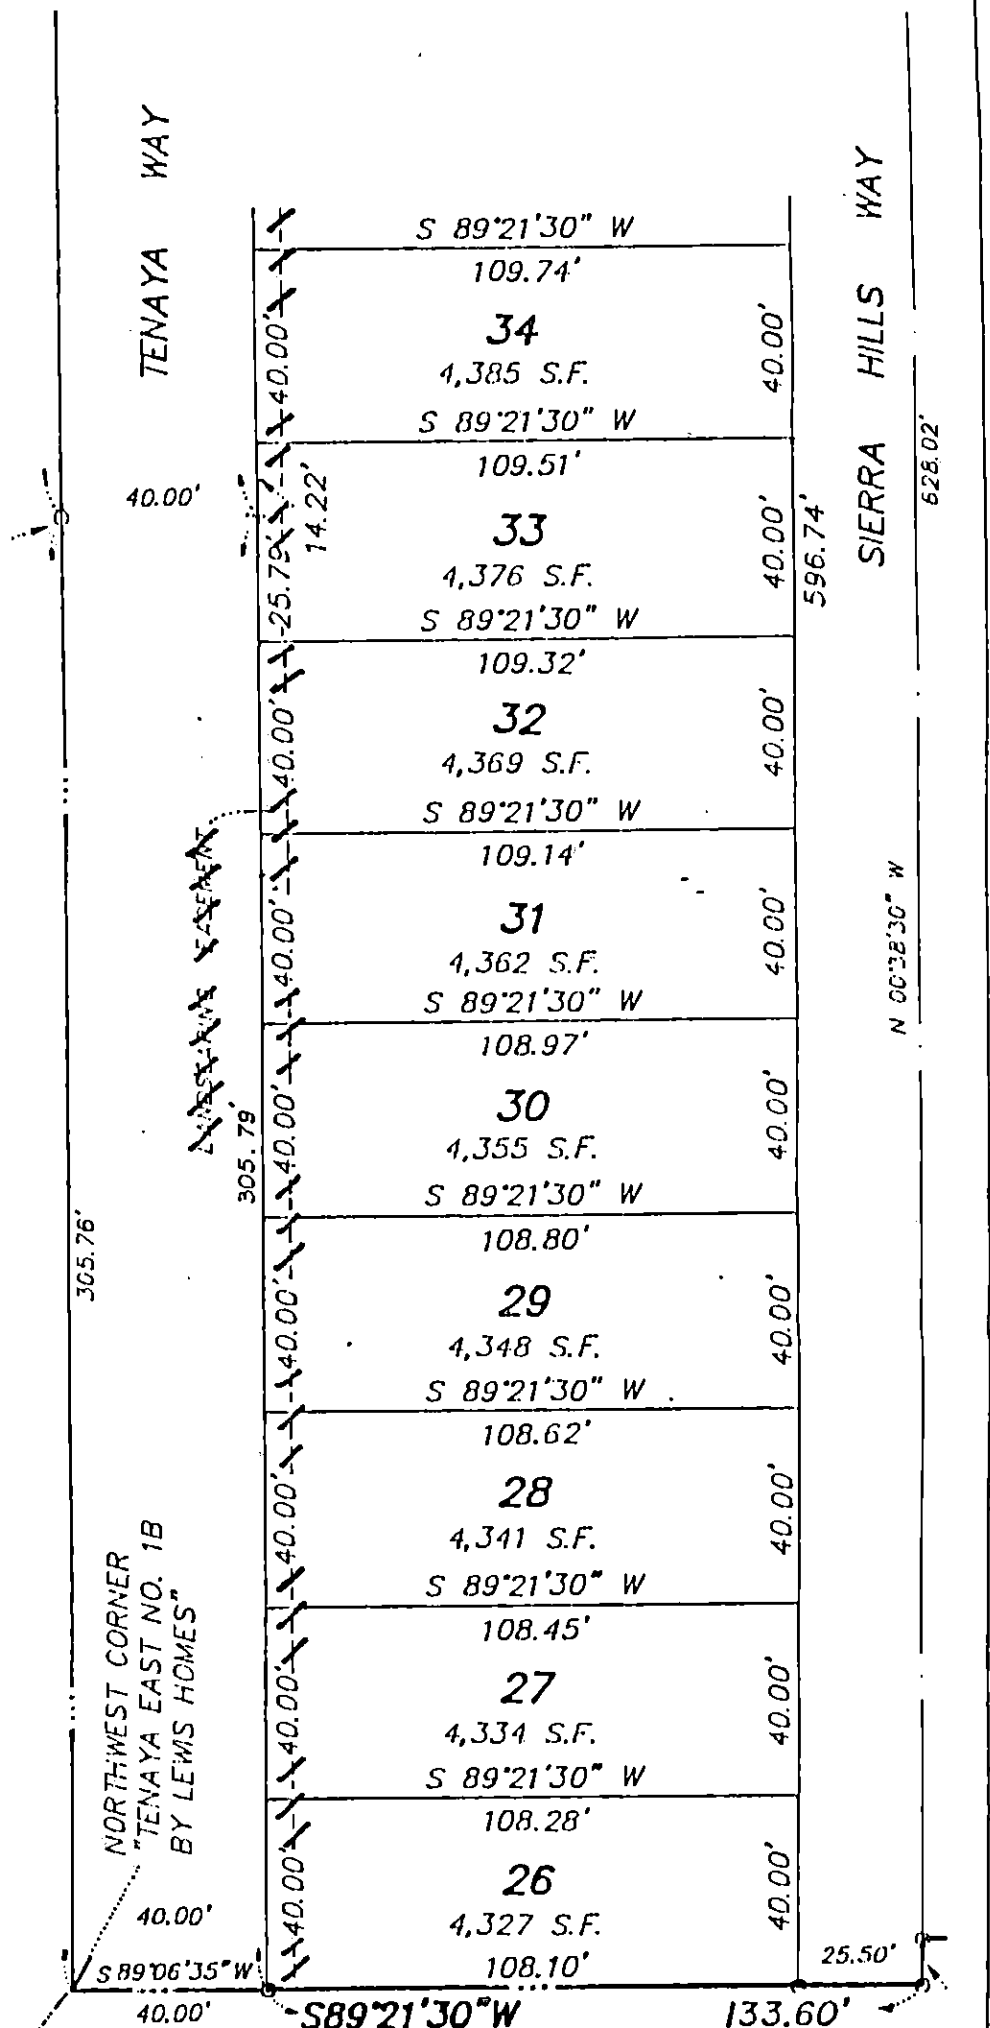


TENAYA EAST NO.1A BY LEWIS HOMES

SHEET 3 OF 3 BOOK 48 PAGE 44 OF PLATS

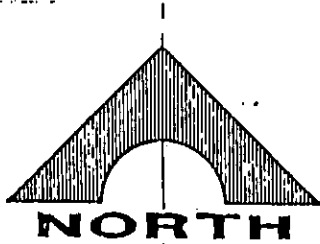




SCALE 1" = 40'

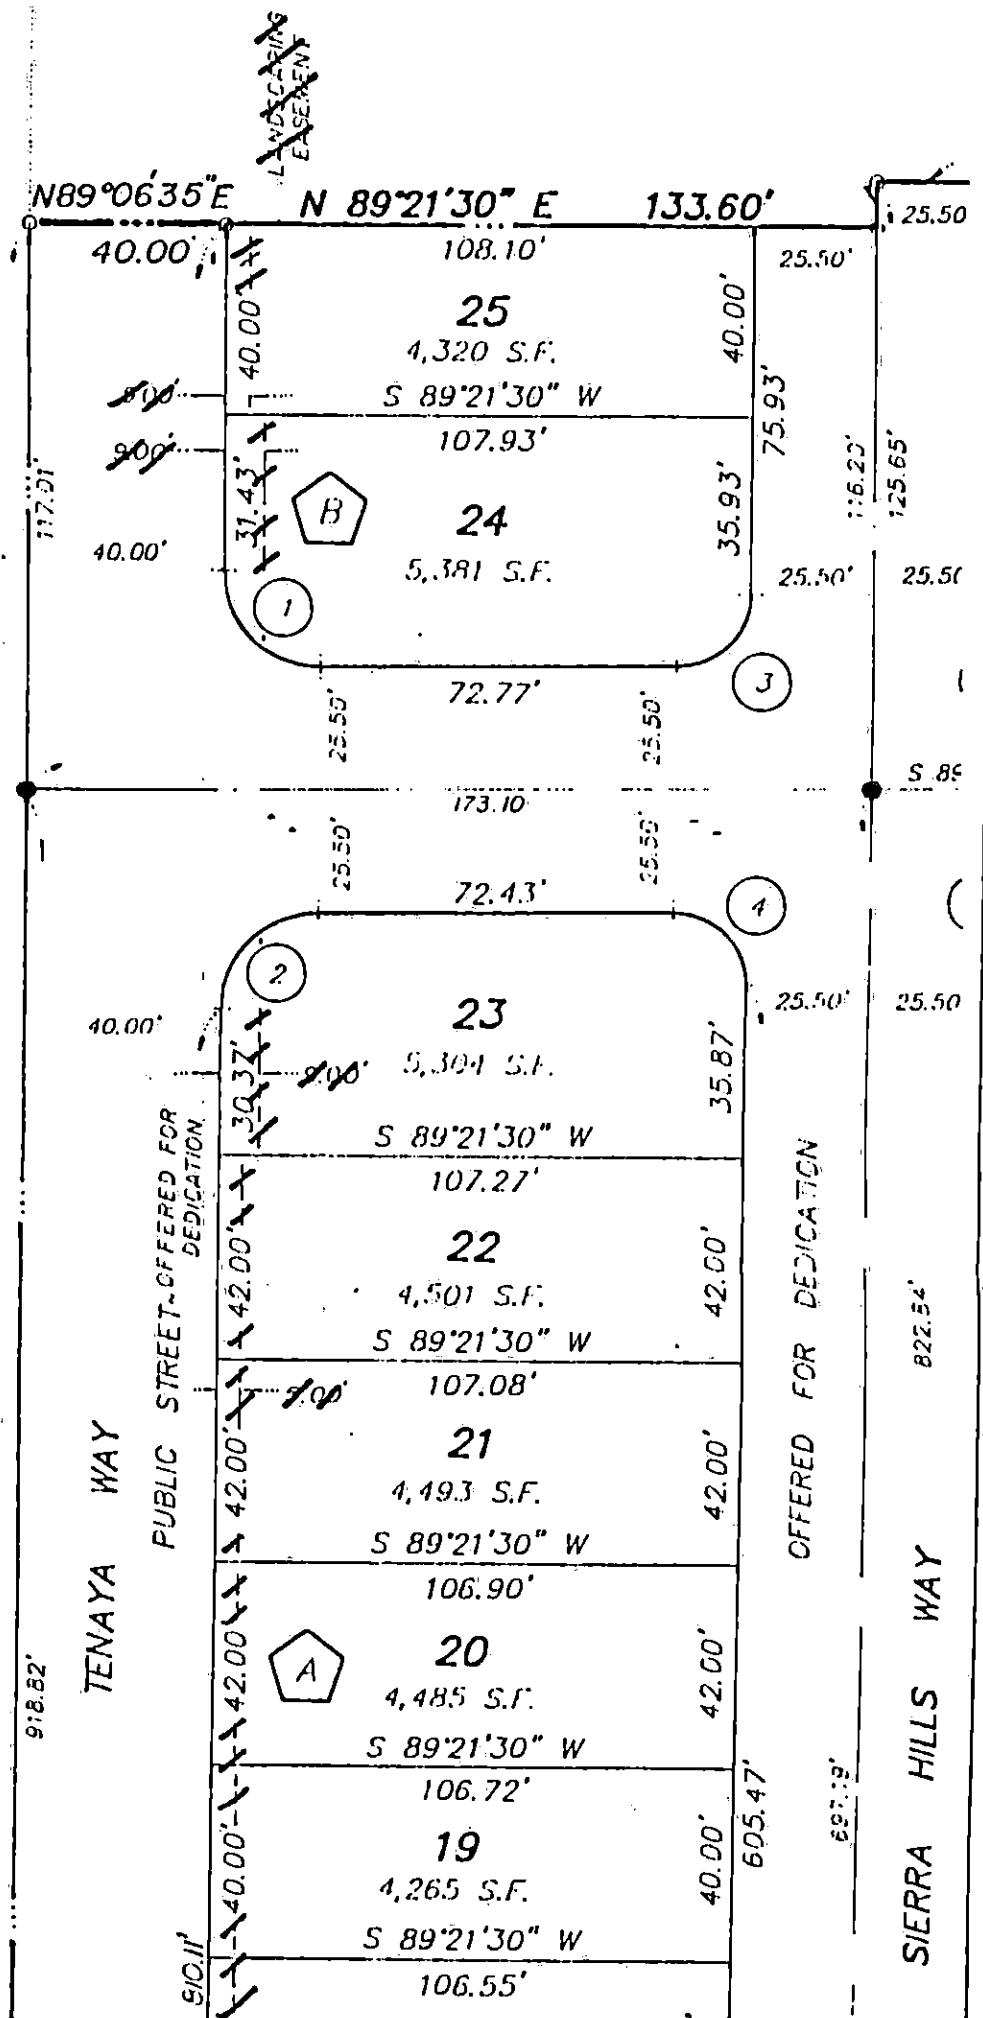


**TENAYA EAST NO.1B
BY LEWIS HOMES**

SHEET 3 OF 4 BOOK 47 PAGE 88 OF PLATS

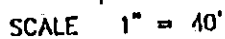


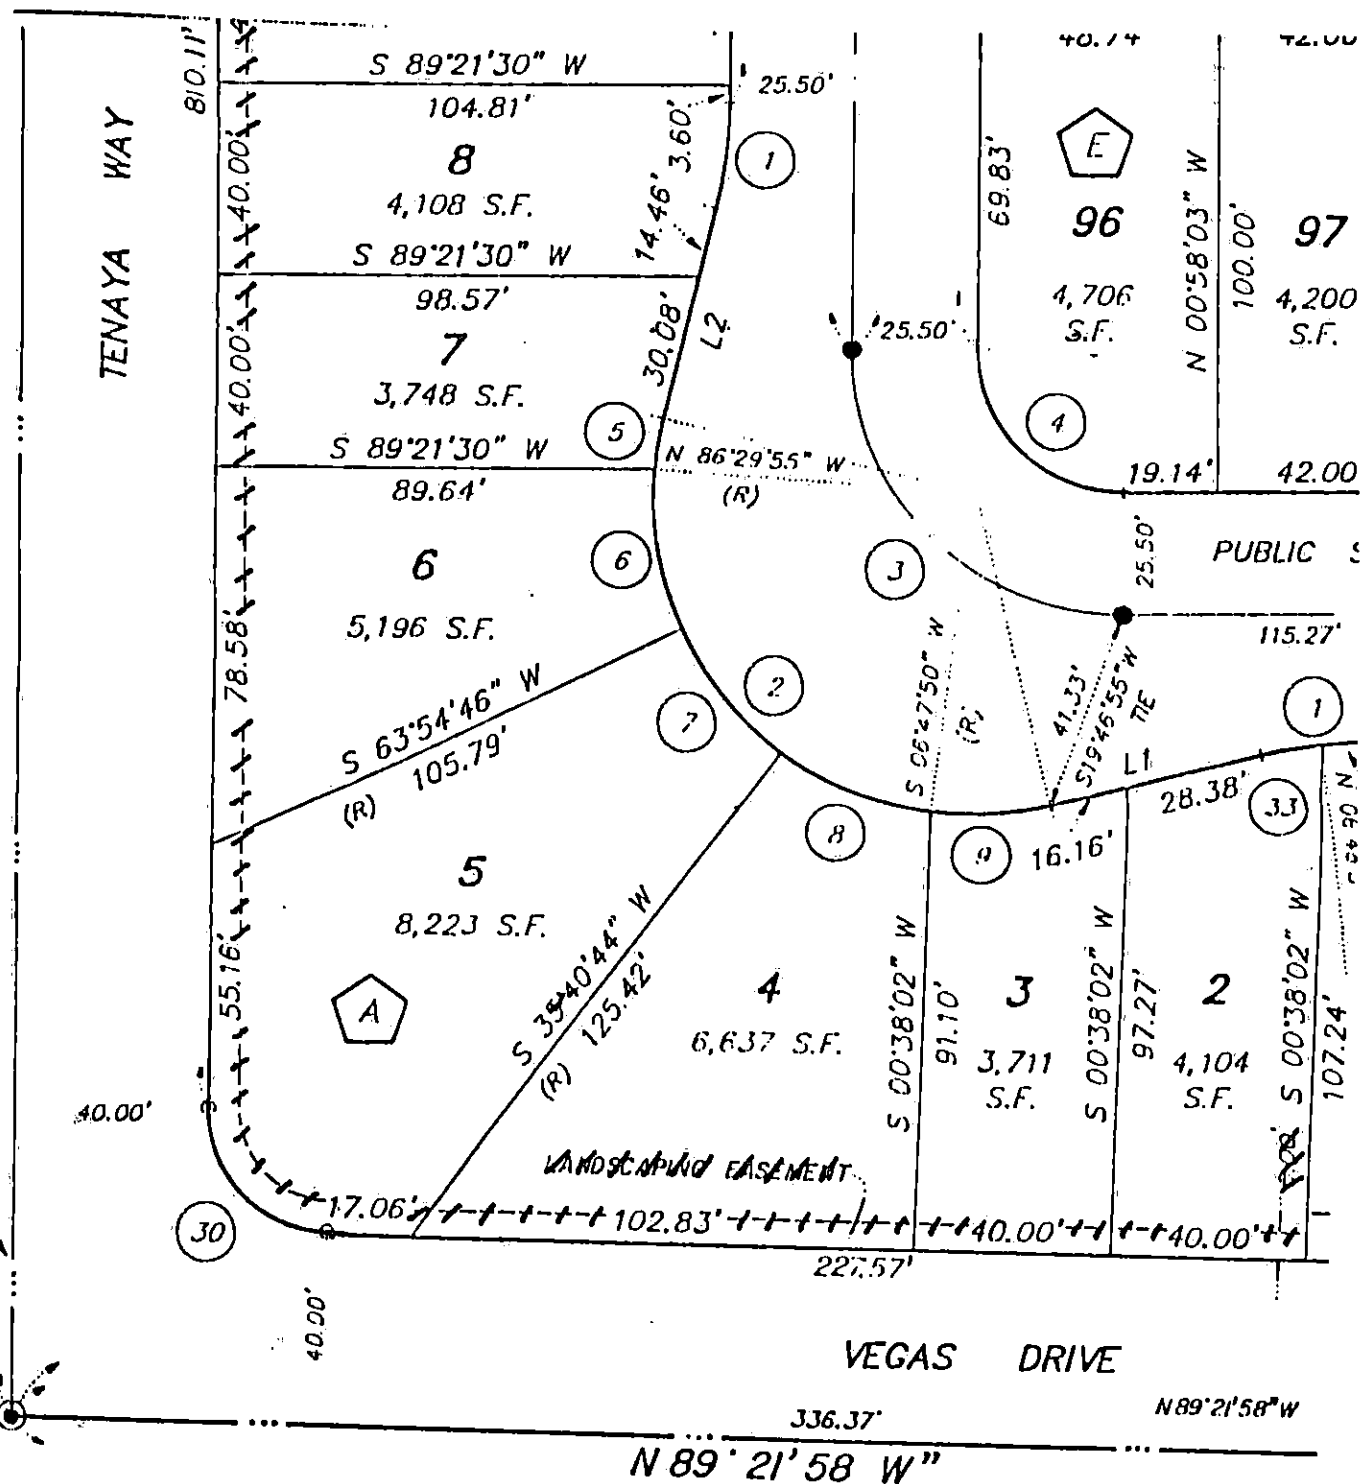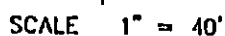

SHEET 4 OF 4 BOOK 47 PAGE 88 OF PLATS

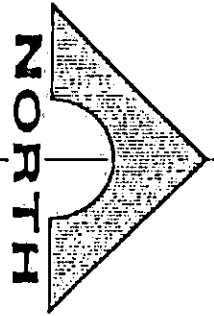

SCALE 1" = 40'

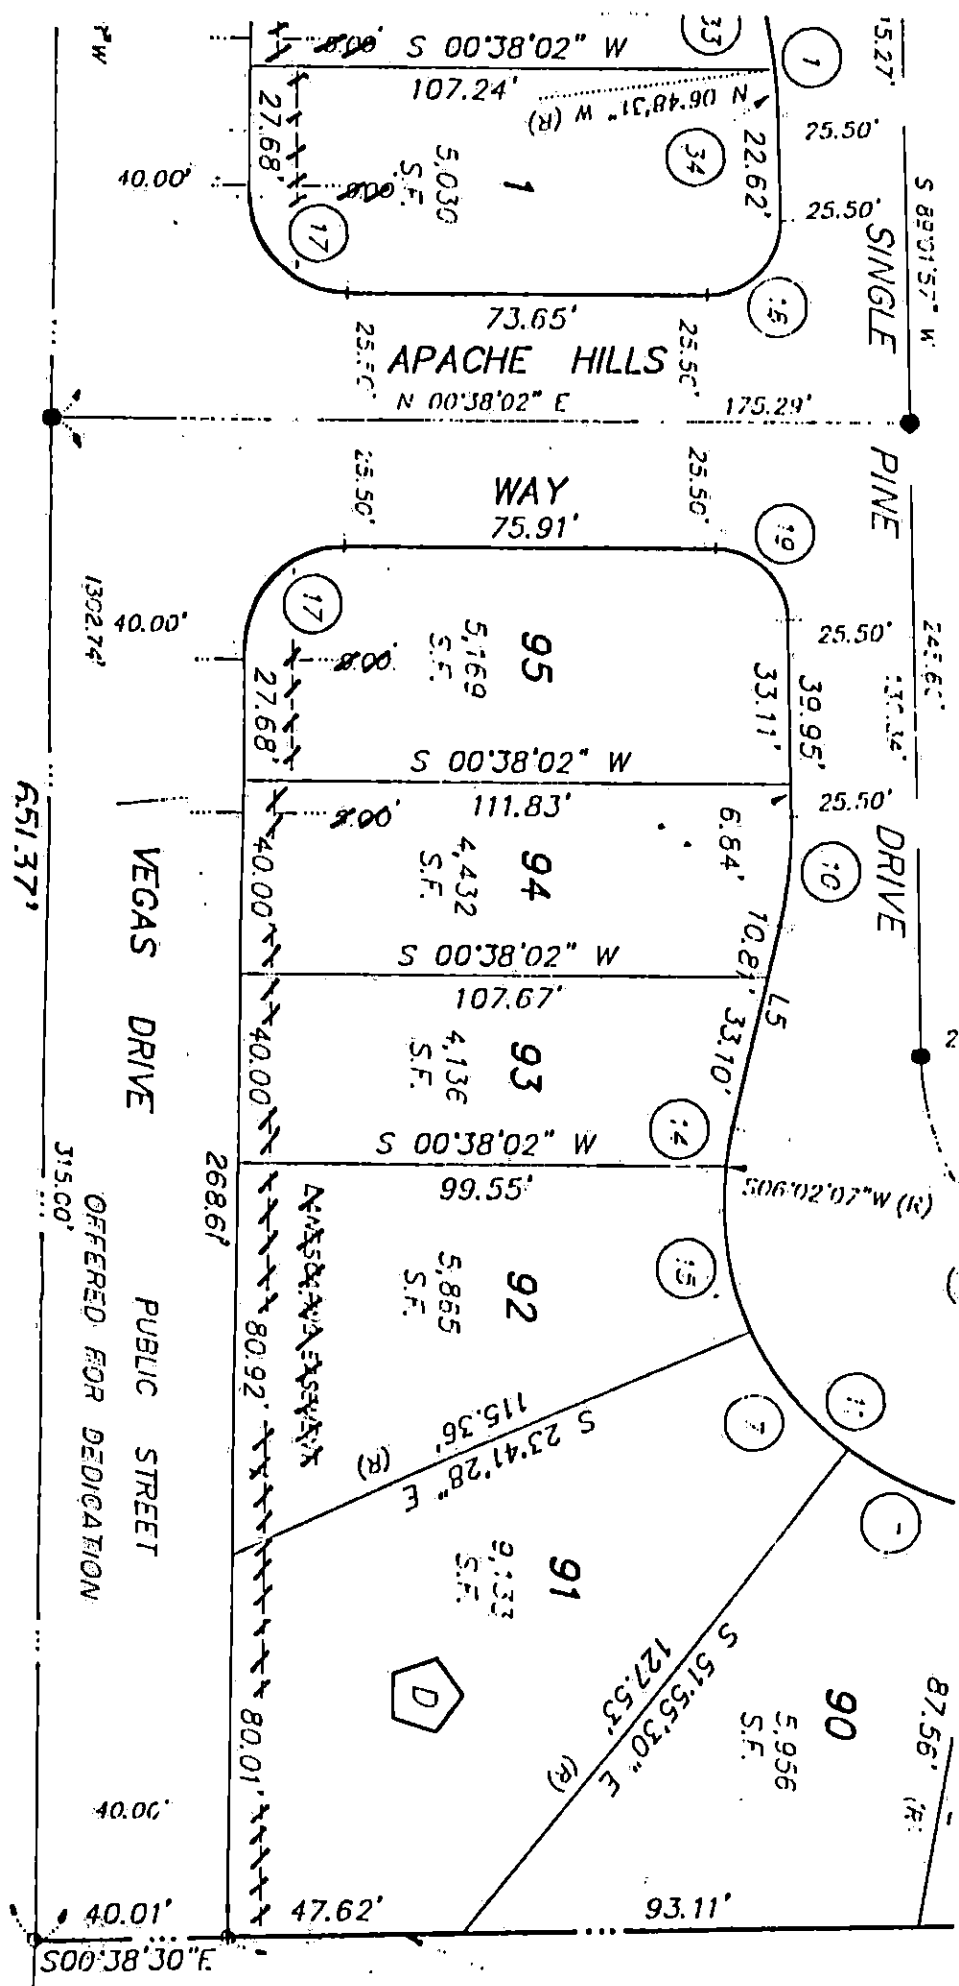

**TENAYA EAST NO.1B
BY LEWIS HOMES**

SHEET 4 OF 4 BOOK 47 PAGE 88 OF PLATS